

**LAND CORNER RECORDATION CERTIFICATE**  
 Filing Requirement of Act 74, Mich. P.A. 1970

For corners in

<u>Macomb</u> (County)	Located In: Washington Township	Corner Code # C-12
1. Public Land Survey	T <u>4N</u> R <u>12E</u>	<u>C-12</u>
	T _____ R _____	_____
	T _____ R _____	_____
2. Property Controlling in Section	S _____ T _____ R _____	_____
	S _____ T _____ R _____	_____
3. Miscellaneous Property in Sec.	S _____ T _____ R _____	_____
	S _____ T _____ R _____	_____

Register of Deeds Stamp & File Number

4. Lot No. \_\_\_\_\_ Recorded Plat \_\_\_\_\_  
 5. Private Claims \_\_\_\_\_

I, Huston K. Kennedy, in a field survey on April 15, 1999 do hereby state that under requirements of P.A. 74, Michigan P.A. of 1970, the corner points mentioned in lines 1 and 2 above were in conformance with regulations and rules therefore as required in the current manual of survey instructions of the United States Department of the Interior, Bureau of Land Management or by a decree of a Court of Law and/or that the corner points mentioned in lines 3, 4 and 5 above were in conformance with the rules of the Michigan Board of Land Surveyors or by a Decree of a Court of Law; established, re-established, monumented, recovered, found as expressed below:

	A	B	C	D	E	F	G	H	I	J	K	L	M
1													
2		6		5		4		3		2		1	
3													
4		7		8		9		10		11		12	
5													
6		18		17		16		15		14		13	
7													
8		19		20		21		22		23		24	
9													
10		30		29		28		27		26		25	
11													
12		31		32		33		34		35		36	
13													

NOTE: Not more than 2 corners, all in the same town and range, may be recorded on this certificate.

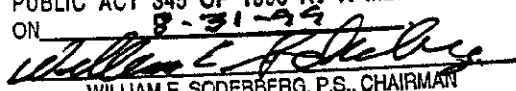
- A. Description of original monument and accessories and/or subsequent restoration:  
 1817-GLO Wampler, D.S.; Set Post 26" White S13°W 13 Links; 18" White Oak N64E 26 Links
- B. Description of corner evidence found and/or method applied in restoring or reestablishing corner:  
 1999-Kennedy Surveying, Inc. - Kennedy, PS #17623 - The corner as recovered is located in a old abandon road bed extending to the East & West, also is located 33 feet ± North of a old fence & tree row extending to the East & West.

The corner was set at the midpoint on a straight line between C-13 & C-11.

**FIELD MEASUREMENTS BETWEEN**

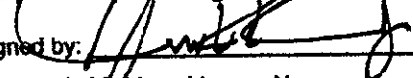
**C-12 to C-11**  
 GLO = 40 chains or 2640.00 Ft.  
 No recorded distances  
 2646.14 Ft. (MEA 1999)

**C-12 to C-13**  
 GLO = 40 chains or 2640.00 Ft.  
 No recorded distances  
 2646.14 Ft. (MEA 1999)

ACCEPTED BY THE MACOMB COUNTY SURVEY PEER GROUP AS THE OFFICIAL CORNER UNDER MICHIGAN PUBLIC ACT 345 OF 1990 AT A MEETING HELD ON 8-31-99  
  
 WILLIAM E. SODERBERG, P.S., CHAIRMAN

- C. Description of monument for corner and accessories established to perpetuate locating the position of the corner:  
 C-12 I set a 4" diameter Concrete Monument with a 1/2" Iron Rod 36" long w/2" diameter aluminum cap stamped "Macomb County Monument, MI Act #345, PS #17623  
 N47°E 48.75' Set Mag Nail & Remon Washer SE face 37" Oak  
 S71°E 68.18' Set Mag Nail & Remon Washer North face 16" Oak  
 N48°W 46.63' Set Mag Nail & Remon Washer SW face 14" Cedar  
 S41°W 31.35' Set Mag Nail & Remon Washer NW face 25" Oak

The selected location is accepted by me and is generally accepted by Professional Surveyors as the best available evidence of the position of the original corner.

Signed by:  \_\_\_\_\_  
 Surveyor's Michigan License No. 17623

Date 9-1-99

907