

**LAND CORNER RECORDATION CERTIFICATE**  
 Filing Requirement of Act 74, Mich. P.A. 1970

For corners in


<u>Macomb</u> (County)	Located In: Washington Township	Corner Code # D-7
1. Public Land Survey	T <u>4N</u> R <u>12E</u>	<u>D-7</u>
	T _____ R _____	_____
	T _____ R _____	_____
	T _____ R _____	_____
2. Property Controlling in Section	S _____ T _____	_____
	S _____ T _____	_____
3. Miscellaneous Property in Sec.	S _____ T _____	_____
	S _____ T _____	_____

Register of Deeds Stamp & File Number

4. Lot No. \_\_\_\_\_ Recorded Plat \_\_\_\_\_  
 5. Private Claims \_\_\_\_\_

I, Huston K. Kennedy, in a field survey on April 15, 1999 do hereby state that under requirements of P.A. 74, Michigan P.A. of 1970, the corner points mentioned in lines 1 and 2 above were in conformance with regulations and rules therefore as required in the current manual of survey instructions of the United States Department of the Interior, Bureau of Land Management or by a decree of a Court of Law and/or that the corner points mentioned in lines 3, 4 and 5 above were in conformance with the rules of the Michigan Board of Land Surveyors or by a Decree of a Court of Law; established, re-established, monumented, recovered, found as expressed below:

NOTE: Not more than 2 corners, all in the same town and range, may be recorded on this certificate.

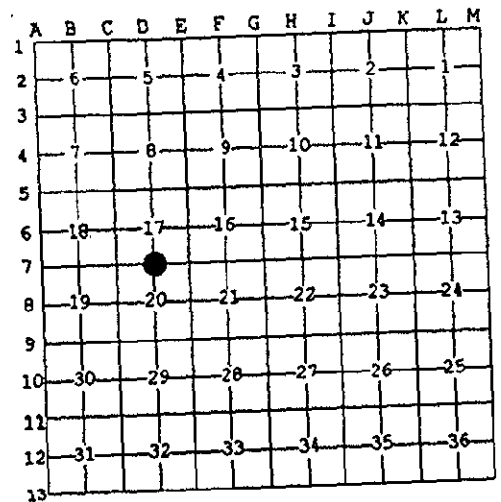

- A. Description of original monument and accessories and/or subsequent restoration:  
 1817-GLO Wampler, D.S.; Set Post 16" Black Oak N76°W 59 Links; 18" Black Oak S18°E 40 Links
- B. Description of corner evidence found and/or method applied in restoring or reestablishing corner:  
 1999-Kennedy Surveying, Inc. - Kennedy, PS #17623 - Fnd a 1/2" Iron Rod 1' below the ground surface. The found 1/2" Iron Rod was beside a broken off 4-way corner fence post with a fence extending to the North, South, East & West. The location of this corner per the coordinates for the horizontal control map for Stoney Creek Park dated July 7, 1960 would be located South 81°33' East 11.25 feet, which I did not accept. I found no other evidences to dispute the location of this corner.

**FIELD MEASUREMENTS BETWEEN**

D-7 to C-7  
 GLO = 40.90 chains or 2699.40 Ft.  
 No recorded distances  
 2665.23 Ft. (MEA 1999)

D-7 to E-7  
 GLO = 40.90 chains or 2699.40 Ft.  
 No record distances  
 2752.74 Ft. (MEA 1999)

ACCEPTED BY THE MACOMB COUNTY SURVEY PEER GROUP AS THE OFFICIAL CORNER UNDER MICHIGAN PUBLIC ACT 345 OF 1990 AT A MEETING HELD ON 7-27-99  
  
 WILLIAM E. SODERBERG, P.S., CHAIRMAN



- C. Description of monument for corner and accessories established to perpetuate locating the position of the corner:  
 D-7 I replaced the found 1/2" Iron Rod with a 4" diameter Concrete Monument with a 1/2" Iron Rod 36" long w/2" a diameter aluminum cap stamped "Macomb County Monument, MI Act #345", PS #17623  
 Due North 33.93' Set Mag Nail & Remon Washer West face 12" Cherry  
 N86°W 5.00' Set Mag Nail & Remon Washer North face 30" Cherry  
 S07°W 41.85' Set Mag Nail & Remon Washer East face 28" Oak  
 Due West 43.60' Set Mag Nail & Remon Washer South face 18" Poplar

The selected location is accepted by me and is generally accepted by Professional Surveyors as the best available evidence of the position of the original corner.

Signed by:   
 Surveyor's Michigan License No. 17623

Date 7-29-99

008