

**LAND CORNER RECORDATION CERTIFICATE**  
Filing Requirement of Act 74, Mich. P.A. 1970

For corners in

Macomb Located In: Corner Code #  
(County) Washington Township

1. Public Land Survey T 4N R 12E E-2  
T \_\_\_\_\_ R \_\_\_\_\_  
T \_\_\_\_\_ R \_\_\_\_\_  
T \_\_\_\_\_ R \_\_\_\_\_

2. Property Controlling in Section S \_\_\_\_\_ T \_\_\_\_\_ R \_\_\_\_\_  
S \_\_\_\_\_ T \_\_\_\_\_ R \_\_\_\_\_

3. Miscellaneous Property in Sec. S \_\_\_\_\_ T \_\_\_\_\_ R \_\_\_\_\_  
S \_\_\_\_\_ T \_\_\_\_\_ R \_\_\_\_\_

4. Lot No. \_\_\_\_\_, Recorded Plat \_\_\_\_\_

5. Private Claims \_\_\_\_\_


**SURVEY & REMONUMENTATION**  
OCT 19 1998  
SECTION

Register of Deeds Stamp & File Number

I, Huston K. Kennedy, in a field survey on April 10, 1998 do hereby state that under requirements of P.A. 74, Michigan P.A. of 1970, the corner points mentioned in lines 1 and 2 above were in conformance with regulations and rules therefore as required in the current manual of survey instructions of the United States Department of the Interior, Bureau of Land Management or by a decree of a Court of Law and/or that the corner points mentioned in lines 3, 4 and 5 above were in conformance with the rules of the Michigan Board of Land Surveyors or by a Decree of a Court of Law, established, re-established, monumented, recovered, found as expressed below:

NOTE: Not more than 2 corners, all in the same town and range, may be recorded on this certificate.

ACCEPTED BY THE MACOMB COUNTY SURVEY PEER GROUP AS THE OFFICIAL CORNER UNDER MICHIGAN PUBLIC ACT 345 OF 1990 AT A MEETING HELD ON 7/28/96  
William E. Soderberg  
WILLIAM E. SODERBERG, P.S., CHAIRMAN

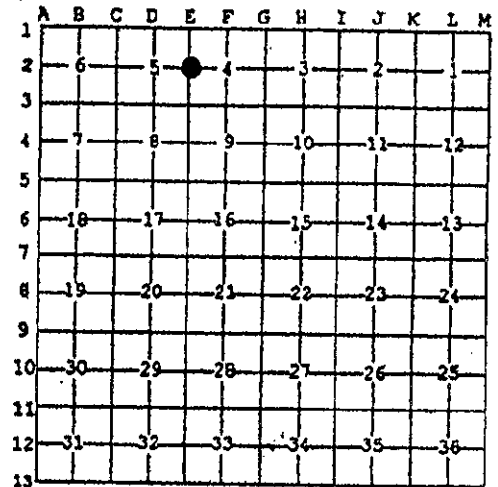

- A. Description of original monument and accessories and/or subsequent restoration:  
1817-GLO Wampler, D.S.; Set Post 11" White Oak N46°E 40 Links; 13" White Oak N33°W 110 Links  
1.) 1992-Avey, PS #30076; LCRC L.5290, Pg.295 - Fnd 1/2" Bar in a Monument Box  
2.) 1997-Dunn, PS #28405; LCRC L.7323, Pg.40 - Fnd 1/2" Iron Rod in a Monument Box  
3.) 1972-Kobs, PS #14097; Survey L.2268, Pg.665 - Fnd 1/2" Iron Bar.  
4.) 1985-Donnelly, PS #21563; Unrecorded Survey - Fnd 1" Iron in a Monument Box  
5.) 1991-Avey, PS #30076; Unrecorded Survey - Fnd 1/2" Iron Bar in a Monument Box, used same wit as 1992 LCRC
- B. Description of corner evidence found and/or method applied in restoring or reestablishing corner:  
1998-Kennedy Surveying, Inc. - Kennedy, PS #17623 - Fnd a 1/2" Iron Rod in a Monument Box located 2 feet West of the existing centerline of Mound Road extending to the North & South, which has a bituminous surface.

Witnesses from LCRC #1, 2, 3 & unrecorded Surveys #4 & 5 were used to recover and verify the location of the found 1/2" Iron Rod in a Monument Box.

I accepted the found 1/2" Iron Rod in a Monument Box as the best evidence of the original corner position.

**FIELD MEASUREMENTS BETWEEN**

<b>E-2 to E-1</b> GLO = 47.88 chains or 3160.08 Ft. No recorded or unrecorded distances 3152.16 Ft. (GPS-GROUND)	<b>E-2 to E-3</b> GLO = 40 chains or 2640.00 Ft. Survey recorded on 3/7/72 in Liber 2268, page 665 = 2551.70 Ft. Unrecorded Survey by Warren C. Avey, PS #30076 dated 7/31/91 = 2551.66 Ft. 2551.59 Ft. (GPS-GROUND)
---	---

- C. Description of monument for corner and accessories established to perpetuate locating the position of the corner:  
E-2 I replaced the found 1/2" Iron Rod with a 3/4" x 24" iron Rod w/2" diameter aluminum cap stamped "Macomb County Monument, MI Act 345" #17623  
N45°E 62.15' Set Mag Nail & Remon Washer NW face Power Pole  
S80°E 38.65' Set Mag Nail & Remon Washer North face 7" Maple  
S15°W 88.45' Set Mag Nail & Remon Washer East face Power Pole  
N30°W 63.81' Set Mag Nail & Remon Washer NE face Power Pole  
West 33.00 feet, found 1/2" Iron Rod with a cap

The selected location is accepted by me and is generally accepted by Professional Surveyors as the best available evidence of the position of the original corner.

Signed by: [Signature]  
Surveyor's Michigan License No. 17623

Date 7-29-98

