

LAND CORNER RECORDATION CERTIFICATE
Filing Requirement of Act 74, Mich. P.A. 1970

SURVEY & REMONUMENTATION

For corners in

OCT 19 1998

Macomb Located in: Corner Code #
(County) Washington Township

- | | | | |
|------------------------------------|-------------|--------------|-------------|
| 1. Public Land Survey | T <u>4N</u> | R <u>12E</u> | E- <u>3</u> |
| | T _____ | R _____ | _____ |
| | T _____ | R _____ | _____ |
| | T _____ | R _____ | _____ |
| 2. Property Controlling in Section | S _____ | T _____ | R _____ |
| | S _____ | T _____ | R _____ |
| 3. Miscellaneous Property in Sec. | S _____ | T _____ | R _____ |
| | S _____ | T _____ | R _____ |


SECTION

ACCEPTED BY THE MACOMB COUNTY SURVEY PEER GROUP AS THE OFFICIAL CORNER UNDER MICHIGAN PUBLIC ACT 345 OF 1990 AT A MEETING HELD ON 7/29/98
William E. Soderberg
WILLIAM E. SODERBERG, P.S., CHAIRMAN

4. Lot No. _____, Recorded Plat _____
5. Private Claims _____

Register of Deeds Stamp & File Number

I, Huston K. Kennedy, in a field survey on April 16, 1998 do hereby state that under requirements of P.A. 74, Michigan P.A. of 1970, the corner points mentioned in lines 1 and 2 above were in conformance with regulations and rules therefore as required in the current manual of survey instructions of the United States Department of the Interior, Bureau of Land Management or by a decree of a Court of Law and/or that the corner points mentioned in lines 3, 4 and 5 above were in conformance with the rules of the Michigan Board of Land Surveyors or by a Decree of a Court of Law; established, re-established, monumented, recovered, found as expressed below:

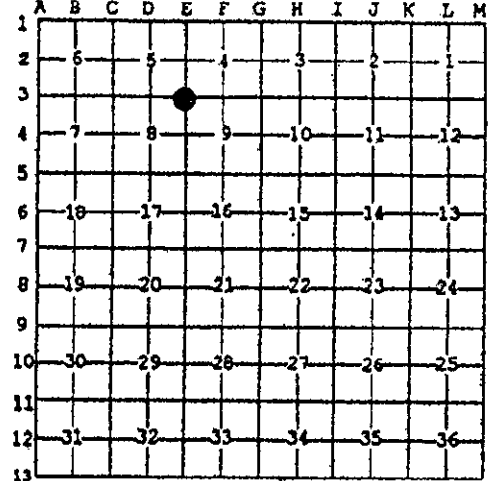

NOTE: Not more than 2 corners, all in the same town and range, may be recorded on this certificate.

- A. Description of original monument and accessories and/or subsequent restoration:
1817-GLO Wampler, D.S.; Set Post 11" White Oak S38°W 9 Links; 14" White Oak N75°E 38 Links
1.) 1992-Avey, PS #30076; LCRC L.5290, Pg.295 - Fnd a Boat Spike
2.) 1972-Kobs, PS #14097; Survey L.2268, Pg.665 - Fnd a Boat Spike

- B. Description of corner evidence found and/or method applied in restoring or reestablishing corner:
1998-Kennedy Surveying, Inc. - Kennedy, PS #17623 - Fnd a Boat Spike 0.80 feet below the road surface, and located in the intersection of 31 Mile Road and Mound Road with the existing centerline of 31 Mile Road extending East & West, which has a gravel surface, also in the existing centerline of Mound Road extending to the North & South, which has a bituminous surface.

Witnesses from LCRC #1 & Survey #2 were used to recover and verify the location of the found Boat Spike.

I accepted the found Boat Spike as the best evidence of the original corner position.

FIELD MEASUREMENTS BETWEEN

E-3 to D-3
GLO = 40.75 chains or 2689.50 Ft
Unrecorded Survey by AEW = 2732.93 Ft
2732.45 Ft (GPS-GROUND)

E-3 to E-4
GLO = 40 chains or 2640.00 Ft
2738.47 Ft (GPS-GROUND)

E-3 to E-2
GLO = 40 chains or 2640.00 Ft
Recorded Survey dated 3/7/72 in Liber 2268, page 665 = 2551.70 Ft
Unrecorded Survey 2551.68 Ft
2551.59 Ft (GPS-GROUND)

E-3 to F-3
GLO = 40.45 chains or 2689.70 Ft
2670.96 Ft (GPS-GROUND)

- C. Description of monument for corner and accessories established to perpetuate locating the position of the corner:
E-3 I replaced the found Boat Spike with a 3/4" x 24" Iron Rod with a 2" diameter aluminum cap stamped "Macomb County Monument, MI Act 345 #17623 in a new Monument Box
S45°W 43.92' Set Mag Nail & Remon Washer SE face Power Pole
S51°E 57.29' Set Mag Nail & Remon Washer SW face Power Pole
N33°W 66.69' Set Mag Nail & Remon Washer NE face Power Pole
N35°E 100.06' Set Mag Nail & Remon Washer NW face 32" Maple

The selected location is accepted by me and is generally accepted by Professional Surveyors as the best available evidence of the position of the original corner.

Signed by: *Huston K. Kennedy*
Surveyor's Michigan License No. 17623

Date 7-29-98

