

**SURVEY & REMONUMENTATION**  
**LAND CORNER RECORDATION CERTIFICATE**  
 Filing Requirement of Act 74, Mich. P.A. 1970

OCT 19 1998

For corners in

Macomb  
 (County)

Located in: Washington Township  
 Corner Code #

SECTION


- |                                    |             |              |            |
|------------------------------------|-------------|--------------|------------|
| 1. Public Land Survey              | T <u>4N</u> | R <u>12E</u> | <u>E-4</u> |
|                                    | T _____     | R _____      | _____      |
|                                    | T _____     | R _____      | _____      |
|                                    | T _____     | R _____      | _____      |
| 2. Property Controlling in Section | S _____     | T _____      | R _____    |
|                                    | S _____     | T _____      | R _____    |
| 3. Miscellaneous Property in Sec.  | S _____     | T _____      | R _____    |
|                                    | S _____     | T _____      | R _____    |

ACCEPTED BY THE MACOMB COUNTY SURVEY PEER GROUP AS THE OFFICIAL CORNER UNDER MICHIGAN PUBLIC ACT 345 OF 1990 AT A MEETING HELD ON 7-29-98  
*William E. Boderberg*  
 WILLIAM E. BODERBERG, P.S., CHAIRMAN  
 Register of Deeds Stamp & File Number

4. Lot No. \_\_\_\_\_, Recorded Plat \_\_\_\_\_  
 5. Private Claims \_\_\_\_\_

I, Huston K. Kennedy, in a field survey on April 15, 1998 do hereby state that under requirements of P.A. 74, Michigan P.A. of 1970, the corner points mentioned in lines 1 and 2 above were in conformance with regulations and rules therefore as required in the current manual of survey instructions of the United States Department of the Interior, Bureau of Land Management or by a decree of a Court of Law and/or that the corner points mentioned in lines 3, 4 and 5 above were in conformance with the rules of the Michigan Board of Land Surveyors or by a Decree of a Court of Law; established, re-established, monumented, recovered, found as expressed below.

NOTE: Not more than 2 corners, all in the same town and range, may be recorded on this certificate.

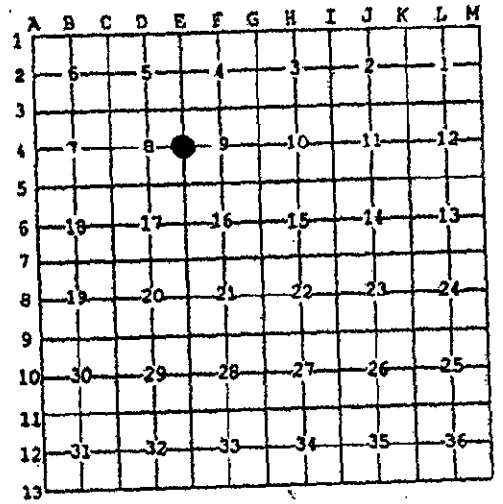

- A. Description of original monument and accessories and/or subsequent restoration:  
 1817-GLO Wampler, D.S.; Set Post 20" White Oak N56°W 91 Links; 18" White Oak N18°E 94 Links  
 1.) 1975-Kobs, PS #14097; LCRC L.2560, Pg.129 - Fnd a 3/8" Iron Bar  
 2.) 1974-Ciernochowski, PS #13577; Survey L.2524, Pg.598 - Object found not stated, no witnesses  
 3.) AEW, Inc. Unrecorded Witnesses - Fnd 1/4" Rerod  
 4.) AEW, Inc. Unrecorded Witnesses - Fnd 3/8" Iron
- B. Description of corner evidence found and/or method applied in restoring or reestablishing corner:  
 1998-Kennedy Surveying, Inc. - Kennedy, PS #17623 - Fnd a 3/8" Iron Rod 0.30 feet below the road surface, located in the existing centerline of Mound Road extending to the North & South, which has a bituminous surface. A fence/tree row extending to the East and a fence row extending to the West.

Witnesses from LCRC #1 & Unrecorded Witnesses #4 were used to recover and verify the location of the found 3/8" Iron Rod.

I accepted the found a 3/8" Iron Rod as the best evidence of the original corner position.

**FIELD MEASUREMENTS BETWEEN**

<u>E-4 to E-3</u> GLO = 40 chains or 2640.00 Ft. 2738.47 Ft. (GPS-GROUND)	<u>E-4 to E-5</u> GLO = 40 chains or 2640.00 Ft. 2651.48 Ft. & 2651.28 Ft. (Unrecorded Survey) 2651.13 Ft. (GPS-GROUND)
---	--

- C. Description of monument for corner and accessories established to perpetuate locating the position of the corner:  
 E-4 I replaced the found 3/8" Iron Rod with a 1/2" x 24" Iron Rod with 2" diameter aluminum cap stamped "Macomb County Monument, MI Act 345" #17623 in a new Monument Box  
 Due West 50.40' Set Mag Nail & Remon Washer South face Power Pole  
 N88°E 43.47' Set Mag Nail & Remon Washer North face Power Pole  
 N52°W 38.04' Set Mag Nail & Remon Washer NE face Wooden Gate Post  
 S47°W 126.22' NE leg at concrete base of Detroit Edison Tower #9523  
 East 32.97 feet, found 1/4" Iron Pipe

The selected location is accepted by me and is generally accepted by Professional Surveyors as the best available evidence of the position of the original corner.



Signed by: *Huston Kennedy*  
 Surveyor's Michigan License No. 17623

Date 7-29-98

FORM APPROVED BY MICHIGAN STATE BOARD OF PROFESSIONAL SURVEYORS, JAN. 28, 1971  
 REVISED MAY 14, 1975  
 PRINTED 12N 1982