

**SURVEY &
REMONUMENTATION**

APR 28 1995

LAND CORNER RECORDATION CERTIFICATE
Filing Requirement of Act 74, Mich. P.A. 1970

C152193

COMMISSION

LIBER 6527 PAGE 770

corners in
Macomb
(County)

Located In: Washington Corner Code #
Twp.

Public Land Survey	T 4N	R 12E	E-6
	T	R	
	T	R	
	T	R	
Property Controlling in Section	S	T	R
Miscellaneous Property in Sec.	S	T	R

94 DEC 14 AM 10:50
Register of Deeds Stamp & File Number
MACOMB COUNTY, MI

Lot No. _____, Recorded Plat _____
Private Claims _____

Huston K. Kennedy, in a field survey on September 10, 1994, hereby certify that under requirements of P.A. 74, Michigan P.A. of 1970, the corner points mentioned in lines 1 and 2 above were in conformance with regulations and rules therefore as required in the recent manual of survey instructions of the United States Department of the Interior, Bureau of Land Management or by a decree of a Court of Law and/or that the corner points mentioned in lines 3, 4 and 5 above were in conformance with the rules of the Michigan Board of Land Surveyors or by a Decree of a Court of Law: established, re-established, monumented, re-monumented, recovered, found as expressed below:

	A	B	C	D	E	F	G	H	I	J	K	L	M
2	6		5		4		3		2		1		
3													
4	7		8		9		10		11		12		
5													
6	18		17		16		15		14		13		
7													
8	19		20		21		22		23		24		
9													
10	30		29		28		27		26		25		
11													
12	31		32		33		34		35		36		
13													

NOTE: Not more than 4 corners, all in the same town and range, may be recorded on this certificate.

Description of original monument and accessories and/or subsequent restoration:
7-GLO Wampler, D.S.; Set Post 10" Black Oak N06°W 55 Links; 13" Black Oak S39°W 1.05 Chains
1983-Kobs, P.S. #14097; LCRC L.3532, Pg.264 - Fnd 1/2" Iron Bar in a Monument Box
1986-Kobs, P.S. #14097; Survey L.3900, Pg.803 - fnd 1/2" Iron Bar in a Monument Box
1993-Kobs, P.S. #14097; Survey L.5831, Pg.257 - Fnd 1/2" Iron Bar in a Monument Box, used same wit as 1986 Survey
1993-Kobs, P.S. #14097; Survey L.5969, Pg.150 - Fnd 1/2" Iron bar in a Monument Box, used same wit as 1986 Survey


Description of corner evidence found and/or method applied in restoring or reestablishing corner:
4-Kennedy Surveying, Inc. - Kennedy, P.S. #17623 - Fnd PK Nail 1.90' West of the centerline of Mound Road, which has a bituminous surface, and the centerline of Inwood Road, which has a gravel surface extending to the West with a line of occupation extending to the East. Also found a Monument Box 6" under bituminous surface with a 1/2" Iron Rod inside. The existing Monument Box was reset flush with the surface of Mound Road.

Witnesses from LCRC #1 & Survey #2 were used to recover and verify the location of the found PK Nail and 1/2" Iron rod in a Monument Box.

FIELD MEASUREMENT BETWEEN
E-6 to E-5 2631.49 Feet
E-6 to E-7 2636.07 Feet

ACCEPTED BY THE MACOMB COUNTY SURVEY PEER GROUP AS THE OFFICIAL CORNER UNDER MICHIGAN PUBLIC ACT 345 OF 1990 AT A MEETING HELD ON 9-20-94
William E. Soderberg
WILLIAM E. SODERBERG, P.S., CHAIRMAN

Description of monument for corner and accessories established to perpetuate locating the position of the corner.
I replaced the found PK Nail and a 1/2" Iron Rod with a 3/4" x 24" Iron Rod w/2" diameter aluminum cap stamped Macomb County Monument MI Act 345 #17623 in a existing Monument Box.
S12°W 100.66' Set PK & Remon. Washer SE face Guide Pole
S27°E 69.90' Set PK & Remon. Washer SW face Power Pole
N44°E 43.01' Set PK & Remon. Washer NW face Power Pole
N34°W 43.09' Set PK & Remon. Washer SW face Guide Pole

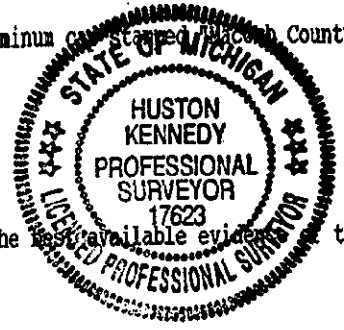

selected location is accepted by me and is generally accepted by Professional Surveyors as the best available evidence of the location of the original corner.

ed by *Huston Kennedy* Date September 20, 1994
Surveyor's Michigan License No. 17623