SURVEY &
REMONUMENTATION

APR 28 1995

COMMISSION

C104999

LAND CORNER RECORDATION CERTIFICATE

Filing Requirement of Act 74, Mich. P.A. 1970

For corners in Macomb (County)

Located In: Washington Township Corner Code ##

LIBER 06415 PG 476

94 AUG -5 PM 1:42

CARMELLA SABAUGH
REGISTER OF DEEDS
MACOMB COUNTY, MI

Register of Deeds Stamp & File Number

1. Public Land Survey T 4 N R 12 E E-7
   T ___ R ___
   T ___ R ___
   T ___ R ___
2. Property Controlling S ___ T ___ R ___
   in Section S ___ T ___ R ___
3. Miscellaneous S ___ T ___ R ___
   Property in Sec. S ___ T ___ R ___

4. Lot No. _____ , Recorded Plat _____
5. Private Claims _____

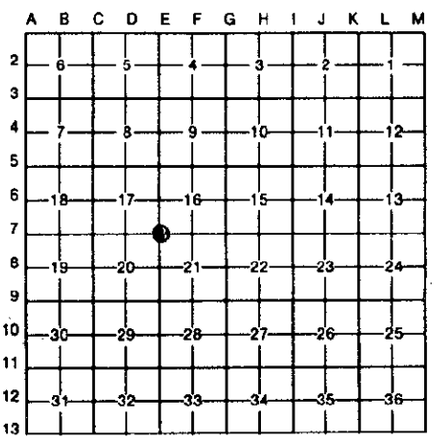

I, Huston K. Kennedy, in a field survey on June 15, 19 94, do hereby certify that under requirements of P.A. 74, Michigan P.A. of 1970, the corner points mentioned in lines 1 and 2 above were in conformance with regulations and rules therefore as required in the current manual of survey instructions of the United States Department of the Interior, Bureau of Land Management or by a decree of a Court of Law and/or that the corner points mentioned in lines 3, 4 and 5 above were in conformance with the rules of the Michigan Board of Land Surveyors or by a Decree of a Court of Law; established, re-established, monumented, re-monumented, recovered, found as expressed below:

NOTE: Not more than 4 corners, all in the same town and range, may be recorded on this certificate.

A. Description of original monument and accessories and/or subsequent restoration:

1817-GLO Wampler, D.S.; Set Post; 18" Black Oak S21*W 52 Links; 16" Black Oak N52*E 17 Links
1.) 1979-Verba, P.S. #13603; LCRC L.3074, Pg.11 - Fnd 1/2" Re-rod in a Monument Box.
2.) 1980-Kobs, P.S. #14097; LCRC L.3295, Pg.780 - Fnd 1/2" Iron Bar in a Monument Box.
3.) 1987-Stonerock, P.S. #13601; LCRC L.4185, Pg.91 - Fnd Monument Box.
4.) 1980-Kobs, P.S. #14097; Survey L.3295, Pg.766 - Fnd 1/2" Iron Bar in a Monument Box, used same wit as 1979 LCRC
5.) 1983-Kobs, P.S. #14097; Survey L.3515, Pg.701 - Fnd 1/2" Iron Bar in a Monument Box, used same wit as 1979 LCRC
6.) 1990-Kobs, P.S. #14097; Survey L.4866, Pg.876 - Fnd 1/2" Iron Bar in a Monument Box, used same wit as 1979 LCRC

B. Description of corner evidence found and/or method applied in restoring or reestablishing corner:

1994 Kennedy Survey, Inc. - Kennedy, P.S. #17623 - Fnd 1/2" Iron Rod in a Monument Box in the centerline of Mound Road, which has a bituminous surface to the North, and gravel surface to the South, and the centerline of 29 Mile Road, which has a bituminous surface to the East with a tree row extending to the West.

Witnesses from LCRC #2 & 3 were used to recover and verify the location of the found 1/2" Iron Rod in a Monument Box.

FIELD MEASUREMENT BETWEEN

E-7 to F-7 2653.96 Feet
E-7 to E-8 2670.22 Feet

ACCEPTED BY THE MACOMB COUNTY SURVEY PEER GROUP AS THE OFFICIAL CORNER UNDER MICHIGAN PUBLIC ACT 345 OF 1990 AT A MEETING HELD ON 7-19-94
William E. Soderberg
WILLIAM E. SODERBERG, P.S., CHAIRMAN

C. Description of monument for corner and accessories established to perpetuate locating the position of the corner:

E-7 I replaced the found 1/2" Iron Rod in a Monument Box with a 3/4" x 24" Iron Rod w/2" diameter aluminum cap stamped "Macomb County Monument MI Act 345 #17623" in a existing Monument Box.
S85°W 38.72' Set PK & Remon. Washer in North face Power Pole
N30°W 80.34' Set PK & Remon. Washer SE face 26" Elm
N30°E 98.64' Set PK & Remon. Washer SE face Power Pole
S70°E 69.57' Set PK & Remon. Washer SW face Power Pole

The selected location is accepted by me and is generally accepted by Professional Surveyors as the best available evidence of the position of the original corner.

STATE OF MICHIGAN
HUSTON KENNEDY
PROFESSIONAL SURVEYOR
17623
LICENSED PROFESSIONAL SURVEYOR

Signed by _____ Date July 21, 1994

Surveyor's Michigan License No. 17623

FORM APPROVED BY MICHIGAN STATE BOARD OF LAND SURVEYORS, JAN. 28, 1971
REVISED MAY 14, 1975
REVISED JAN., 1983