

**SURVEY &
REMONUMENTATION**

C126145

APR 28 1995

COMMISSION

LAND CORNER RECORDATION CERTIFICATE

Filing Requirement of Act 74, Mich. P.A. 1970

SEP 30 AM 9:00

For corners in

Macomb
(County)

Washington

Located in: Township Corner Code #


CARMELLA SABAUGH
REGISTER OF DEEDS
MACOMB COUNTY, MI

- | | | | | | |
|------------------------------------|---|-----------|---|------------|------------|
| 1. Public Land Survey | T | <u>4N</u> | R | <u>12E</u> | <u>E-9</u> |
| | T | _____ | R | _____ | _____ |
| | T | _____ | R | _____ | _____ |
| | T | _____ | R | _____ | _____ |
| 2. Property Controlling in Section | S | _____ | T | _____ | _____ |
| | S | _____ | T | _____ | _____ |
| 3. Miscellaneous Property in Sec. | S | _____ | T | _____ | _____ |
| | S | _____ | T | _____ | _____ |
4. Lot No. _____, Recorded Plat _____
5. Private Claims _____

LIBER 06464PC458

Register of Deeds Stamp & File Number

I, Huston K. Kennedy in a field survey on July 5, 19 94, do hereby certify that under requirements of P.A. 74, Michigan P.A. of 1970, the corner points mentioned in lines 1 and 2 above were in conformance with regulations and rules therefore as required in the current manual of survey instructions of the United States Department of the Interior, Bureau of Land Management or by a decree of a Court of Law and/or that the corner points mentioned in lines 3, 4 and 5 above were in conformance with the rules of the Michigan Board of Land Surveyors or by a Decree of a Court of Law; established, re-established, monumented, re-monumented, recovered, found as expressed below:

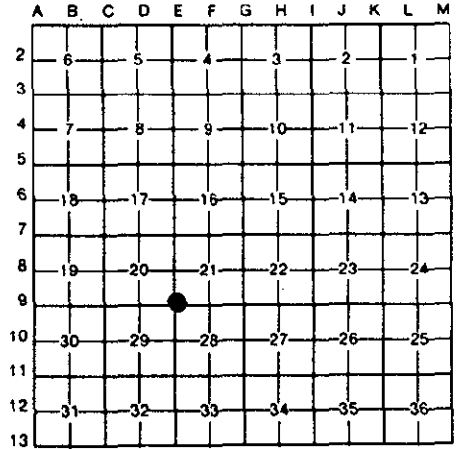

NOTE: Not more than 4 corners, all in the same town and range, may be recorded on this certificate.

A. Description of original monument and accessories and/or subsequent restoration:

- 1817-GLO Wampler, D.S.; Set Post; 10" White Oak S54*W 22 Links; 14" White Oak N45*W 15 Links
- 1.) 1979-Verba, P.S. #13603; LCRC L.3074, Pg.10 - Fnd 3/4" Iron Bar in a Monument Box
 - 2.) 1972-Avey, P.S. #15396; Survey L.2314, Pg.243 - Fnd 1/2" Iron Pipe in hand hole
 - 3.) 1974-Kobs, P.S. #14097; Survey L.2534, Pg.451 - Fnd 1/2" Iron Pipe in a Monument Box
 - 4.) 1974-Avey, P.S. #15396; Survey L.2560, Pg.317 - Fnd 1/2" Iron Pipe in a Box

B. Description of corner evidence found and/or method applied in restoring or reestablishing corner:

1994 Kennedy Surveying, Inc. - Kennedy, P.S. #17623 - Fnd 1/2" Iron Pipe in a Monument Box in the centerline of Mound Road, which has a gravel surface, and the centerline of 28 Mile Road, which has a bituminous surface.

Witnesses from LCRC #1 were the only ones that would verify the location of the found 1/2" Iron Pipe in a Monument Box.

FIELD MEASUREMENT BETWEEN

- E-9 to E-8 2576.00 Feet
- E-9 to E-10 2712.48 Feet
- E-9 to E-9 2717.68 Feet

ACCEPTED BY THE MACOMB COUNTY SURVEY PEER GROUP AS THE OFFICIAL CORNER UNDER MICHIGAN PUBLIC ACT 345 OF 1990 AT A MEETING HELD ON 8-16-94

William E. Soderberg
WILLIAM E. SODERBERG, P.S., CHAIRMAN

C. Description of monument for corner and accessories established to perpetuate locating the position of the corner:

- E-9 I replaced the found 1/2" Iron Pipe in a Monument Box with 3/4" x 24" Iron Rod w/2" diameter aluminum cap stamped "Macomb County Monument" MI Act 345 #17623" in a existing Monument Box.
- N50°W 48.04' Set PK & Remon. Washer SW face Power Pole
 - N40°W 57.14' Set PK & Remon. Washer East face 13" Pine
 - N45°E 41.81' Set PK & Remon. Washer NW face Guide Pole
 - S45°W 43.92' Set PK & Remon. Washer NW face Guide Pole

The selected location is accepted by me and is generally accepted by Professional Surveyors as the best available evidence of the position of the original corner.

Signed by *Huston K. Kennedy* Date August 19 1994
Surveyor's Michigan License No. 17623

