

LAND CORNER RECORDATION CERTIFICATE
Filing Requirement of Act 74, Mich. P.A. 1970

For corners in

Macomb
(County)

Located In: Washington Township Corner Code #

- | | | | |
|------------------------------------|-------------|--------------|------------|
| 1. Public Land Survey | T <u>4N</u> | R <u>12E</u> | <u>G-3</u> |
| | T _____ | R _____ | _____ |
| | T _____ | R _____ | _____ |
| | T _____ | R _____ | _____ |
| 2. Property Controlling in Section | S _____ | T _____ | R _____ |
| | S _____ | T _____ | R _____ |
| 3. Miscellaneous Property in Sec. | S _____ | T _____ | R _____ |
| | S _____ | T _____ | R _____ |
4. Lot No. _____, Recorded Plat _____
5. Private Claims _____

SURVEY &
REMONUMENTATION

OCT 19 1998


SECTION

Register of Deeds Stamp & File Number

I, Huston K. Kennedy, in a field survey on April 24, 1998 do hereby state that under requirements of P.A. 74, Michigan P.A. of 1970, the corner points mentioned in lines 1 and 2 above were in conformance with regulations and rules therefore as required in the current manual of survey instructions of the United States Department of the Interior, Bureau of Land Management or by a decree of a Court of Law and/or that the corner points mentioned in lines 3, 4 and 5 above were in conformance with the rules of the Michigan Board of Land Surveyors or by a Decree of a Court of Law, established, re-established, monumented, recovered, found as expressed below:

NOTE: Not more than 2 corners, all in the same town and range, may be recorded on this certificate.

- A. Description of original monument and accessories and/or subsequent restoration:
1817-GLO Wampler, D.S.; Set Post 24° Elm S27°E 9 Links; 8° Lynn N41°E 7 Links
- 1973-Buckerfield, PS #10868; LCRC L.2462, Pg.979 - Fnd 1" Iron Bar
 - 1979-Fenn, PS #23505; LCRC L.3168, Pg.263 - Fnd 1-1/2" Steel Bar
 - 1988-Avey, PS #30076; LCRC L.4353, Pg. 431 - Fnd a 1" Bar
 - 1990-Avey, PS #30076; LCRC L.5014, Pg.17 - Fnd 1/2" Bar #14097
 - 1998-Wright, PS #40165; LCRC L.7253, Pg.886 - Fnd 1/2" Bar #14097

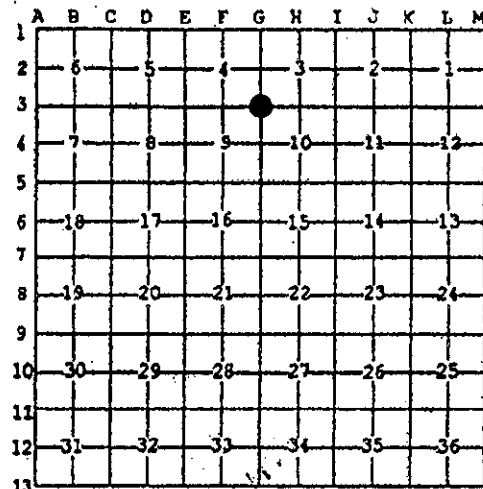

(Con't back side of LCRC)

- B. Description of corner evidence found and/or method applied in restoring or reestablishing corner:
1998-Kennedy Surveying, Inc. - Kennedy, PS #17623 - Fnd a 1/2" Iron Rod .60 feet below the surface, and located 3 feet North of the existing centerline of 31 Mile Road extending East & West, which has a gravel surface, and 3 feet East of the existing centerline of Camp Ground Road extending to the North & South, which has a gravel surface.

Witnesses from LCRC #1, 2, 3, 4, 5, Survey #7, 16 & 19 were used to recover and verify the location of the found 1/2" Iron Rod.

I accepted the found 1/2" Iron Rod as the best evidence of the original corner position.

ACCEPTED BY THE MACOMB COUNTY SURVEY PEER GROUP AS THE OFFICIAL CORNER UNDER MICHIGAN PUBLIC ACT 345 OF 1990 AT A MEETING HELD ON 7/28/98

William E. Soderberg
WILLIAM E. SODERBERG, P.S., CHAIRMAN

FIELD MEASUREMENTS BETWEEN

G-3 to F-3

GLO = 40.45 chains or 2669.70 Ft
Surveys recorded in Liber 2882, page 457, Liber 3074, page 527, Liber 3355, page 488 = 2672.50 Ft
Unrecorded Survey by Warren C. Avey, PS #30076 = 2673.02 Ft.
2673.17 Ft. (GPS-GROUND)

(Con't on back side of LCRC)

- C. Description of monument for corner and accessories established to perpetuate locating the position of the corner:
G-3 I replaced the found 1/2" Iron Rod with a 3/4" x 24" Iron Rod with 2" diameter aluminum cap stamped "Macomb County Monument, MI Act #345" #17623
S61°E 117.45' Set Mag Nail & Remon Washer North face 27" Oak
S47°W 62.22' Set Mag Nail & Remon Washer NW face Power Pole
N45°E 47.44' Set Mag Nail & Remon Washer NW face Power Pole
N45°W 37.23' Set Mag Nail & Remon Washer SW face Light Pole

The selected location is accepted by me and is generally accepted by Professional Surveyors as the best available evidence of the position of the original corner.

Signed by: [Signature]
Surveyor's Michigan License No. 17623

Date 7-29-98



9x✓

- 6.) 1996-Wright, PS #40165; LCRC L.7253, Pg.887 – Fnd ½" Bar #14097, used same wit as 1996 LCRC
- 7.) 1974-Kobs, PS #14097; Survey L.2466, Pg.728 – Fnd 1" Iron Bar
- 8.) 1974-Kobs, PS #14097; Survey L.2488, Pg.343 – Fnd 1" Iron Bar, used same wit as 1974 Survey
- 9.) 1975-Kobs, PS #14097; Survey L.2560, Pg.115 – Fnd 1" Iron Bar, used same wit as 1974 Survey
- 10.) 1975-Kobs, PS #14097; Survey L.2584, Pg.141 – Fnd 1" Iron Bar, used same wit as 1974 Survey
- 11.) 1976-Kobs, PS #14097; Survey L.2653, Pg.35 – Fnd 1" Iron Bar, used same wit as 1974 Survey
- 12.) 1977-Kobs, PS #14097; Survey L.2882, Pg.457 – Fnd 1" Iron Bar, used same wit as 1974 Survey
- 13.) 1978-Kobs, PS #14097; Survey L.2923, Pg.823 – Fnd 1" Iron Bar, used same wit as 1974 Survey
- 14.) 1979-Kobs, PS #14097; Survey L.3062, Pg.594 – Fnd 1" Iron Bar, used same wit as 1974 Survey
- 15.) 1979-Kobs, PS #14097; Survey L.3074, Pg.527 – Fnd 1" Iron Bar, used same wit as 1974 Survey
- 16.) 1981-Kobs, PS #14097; Survey L.3355, Pg.488 – Fnd 1" Iron Bar, used same wit as 1974 Survey
- 17.) 1983-Kobs, PS #14097; Survey L.3532, Pg.258 – Fnd 1" Iron Bar, used same wit as 1974 Survey
- 18.) 1984-Kobs, PS #14097; Survey L.3579, Pg.131 – Fnd 1" Iron Bar, used same wit as 1974 Survey
- 19.) 1985-Kobs, PS #14097; Survey L.3880, Pg.55 – Fnd 1" Iron Bar, used same wit as 1974 Survey
- 20.) 1986-Kobs, PS #14097; Survey L.4055, Pg.612 – Fnd 1" Iron Bar, used same wit as 1974 Survey
- 21.) 1987-King, PS #30085; Survey L.4151, Pg.81 – Fnd 1" Iron Bar
- 22.) 1979-Avey, PS #15396; Unrecorded Survey – Fnd a 1" Bar
- 23.) 1989-Dunn & Associates Land Surveyors; Unrecorded Survey – Fnd 1" Iron Bar, used same wit as Certificate of Survey
- 24.) 1990-Avey, PS #30076; Unrecorded Survey – Fnd ½" Bar #14097, and used same wit as 1990 LCRC
- 25.) 1996-Wright, PS #40165; Unrecorded Survey – Fnd ½" Bar #14097, and used same wit as 1996 LCRC

G-3 to G-4

GLO = 40 chains or 2640.00 Ft.

Surveys recorded in Liber 2560, page 115, Liber 2652, page 35, Liber 2653, page 35 = 2669.97 Ft.

Surveys recorded in Liber 3074, page 527, Liber 3355, page 488 = 2671.11 Ft.

Unrecorded Surveys by Dunn, & Associates = 2671.99 Ft. & Warren C. Avey, PS #30076 = 2671.68 Ft.
2671.87 Ft. (GPS-GROUND)

G-3 to H-3

GLO = 39.55 chains or 2610.30 Ft.

Surveys recorded in Liber 3062, page 584, Liber 3532, page 258 = 2638.32 Ft.

Unrecorded Survey by Dunn & Associates = 2638.45 Ft.

2638.89 Ft. (GPS-GROUND)

G-3 to G-2

GLO = 40 chains or 2640.00 Ft.

Surveys recorded in Liber 2466, page 728, Liber 2488, page 343, Liber 3062, page 594 = 2605.64 Ft.

2604.95 Ft. (GPS-GROUND)

C0752794 LIBER:08201 PAGE:124 02:19P 08/11/1998
CARMELLA SABAUGH-MACOMB COUNTY, MI REG/DEEDS

SURVEY &
REMONUMENTATION

OCT 19 1998

SECTION