

LAND CORNER RECORDATION CERTIFICATE
Filing Requirement of Act 74, Mich. P.A. 1970

For corners in

<u>Macomb</u> (County)	Located In: <u>Washington Township</u>	Corner Code # <u>H-1</u>
1. Public Land Survey	T <u>4N</u> R <u>12E</u>	<u>H-1</u>
	T <u> </u> R <u> </u>	<u> </u>
	T <u> </u> R <u> </u>	<u> </u>
	T <u> </u> R <u> </u>	<u> </u>
2. Property Controlling in Section	S <u> </u> T <u> </u> R <u> </u>	<u> </u>
	S <u> </u> T <u> </u> R <u> </u>	<u> </u>
3. Miscellaneous Property in Sec.	S <u> </u> T <u> </u> R <u> </u>	<u> </u>
	S <u> </u> T <u> </u> R <u> </u>	<u> </u>

SURVEY & REMONUMENTATION

APR 07 1998

SECTION

Register of Deeds Stamp & File Number

4. Lot No. _____, Recorded Plat _____
 5. Private Claims _____

I, Huston K. Kennedy, in a field survey on 5/8, 19 97 do hereby state that under requirements of P.A. 74, Michigan P.A. of 1970, the corner points mentioned in lines 1 and 2 above were in conformance with regulations and rules therefore as required in the current manual of survey instructions of the United States Department of the Interior, Bureau of Land Management or by a decree of a Court of Law and /or that the corner points mentioned in lines 3, 4 and 5 above were in conformance with the rules of the Michigan Board of Land Surveyors or by a Decree of a Court of Law; established, re-established, monumented, recovered, found as expressed below:

NOTE: Not more than 2 corners, all in the same town and range, may be recorded on this certificate.

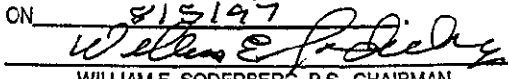
	A	B	C	D	E	F	G	H	I	J	K	L	M
1													
2		6		5			4		3		2		1
3													
4		7		8			9		10		11		12
5													
6		18		17			16		15		14		13
7													
8		19		20			21		22		23		24
9													
10		30		29			28		27		26		25
11													
12		31		32			33		34		35		36
13													

- A. Description of original monument and accessories and/or subsequent restoration:
 1817-GLO Wanpler, D.S.; No post was set
 1.) 1992-Avey, PS #30076; LCRC L.5700, Pg.465 - Set a P.K. Nail
 2.) 1993-Avey, PS #30076; LCRC L.5947, Pg.065 - Set a P.K. Nail, used same wit as 1992 LCRC
 3.) 1983-Urban Land Consultants; unrecorded Survey - Object found not stated, no witnesses

- B. Description of corner evidence found and/or method applied in restoring or reestablishing corner:
 1997 Kennedy Surveying, Inc. - Kennedy, PS #17623 - Fnd P.K. Nail at the surface and 2.40 feet North of the existing centerline of 32 Mile Road extending to the East & West, which has a bituminous surface. The Macomb County Peer Group accepted the position of this corner as a common corner with the South 1/4 corner of Section 34, T5N, R12E, Bruce Township.

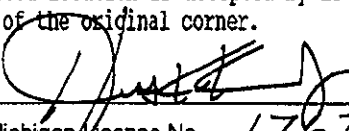
Witnesses from LCRC #1 were used to recover and verify the location of the found P.K. Nail.

See back side of LCRC for Field Measurements

ACCEPTED BY THE MACOMB COUNTY SURVEY PEER GROUP AS THE OFFICIAL CORNER UNDER MICHIGAN PUBLIC ACT 345 OF 1990 AT A MEETING HELD ON 8/5/97

 WILLIAM E. SODERBERG, P.S., CHAIRMAN

- C. Description of monument for corner and accessories established to perpetuate locating the position of the corner:
 H-1 I replaced the found P.K. Nail with a 3/4" x 24" Iron Rod w/2" diameter aluminum cap stamped "Macomb County Monument MI Act 345" #17623 in a new Monument Box
 N27° E 35.85' Set PK & Remon Washer NW face 27" Maple
 N67° W 82.14' Set PK & Remon Washer South face 25" Maple
 S71° W 211.31' Set PK & Remon Washer SW face 24" Oak
 S11° W 127.66' Set PK & Remon Washer East face 12" Elm

The selected location is accepted by me and is generally accepted by Professional Surveyors as the best available evidence position of the original corner.

Signed by 
 Surveyor's Michigan License No. 17623

Date 8-8-97



772

FIELD MEASUREMENTS BETWEEN

H-1 to G-1

No GLO
GPS-MEA = 2622.65 Ft. or GROUND CAL. = 2622.89 Ft.

H-1 to H-13

No GLO
Common Corner

H-1 to I-1

No GLO
GPS-MEA = 2632.74 Ft. or GROUND CAL. = 2632.98 Ft.

C0568789 LIBER:07613 PAGE:801 10:28A 09/02/1997
CARMELLA SABAUGH-MACOMB COUNTY, MI REG/DEEDS