

**SURVEY &  
REMONUMENTATION**

APR 28 1995

**LAND CORNER RECORDATION CERTIFICATE**  
Filing Requirement of Act 74, Mich. P.A. 1970

C152197

corners in  
Macomb

**COMMISSION**

Located In: Washington Corner Code ##  
Twp.

LIBER **6527** PAGE **774**


94 DEC 14 AM 10:50

CARME... BAUGH  
REGISTER OF DEEDS  
MACOMB COUNTY, MI

Register of Deeds Stamp & File Number

Public Land Survey	T	<u>4N</u>	R	<u>12E</u>	<u>H-5</u>
	T		R		
	T		R		
	T		R		
Property Controlling	S		T	R	
in Section	S		T	R	
Miscellaneous	S		T	R	
Property in Sec.	S		T	R	

Lot No. \_\_\_\_\_, Recorded Plat \_\_\_\_\_  
Private Claims \_\_\_\_\_

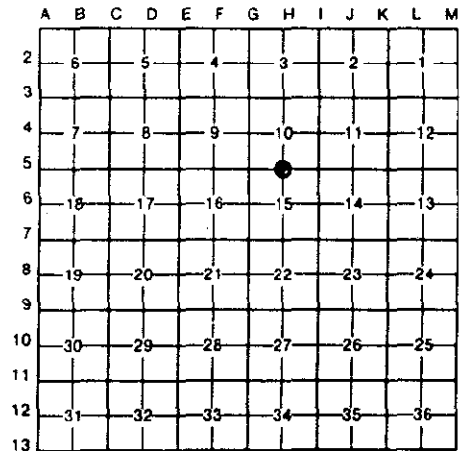

Huston K. Kennedy, in a field survey on September 10 19 94,  
hereby certify that under requirements of P.A. 74, Michigan P.A. of 1970, the corner points mentioned  
lines 1 and 2 above were in conformance with regulations and rules therefore as required in the  
current manual of survey instructions of the United States Department of the Interior, Bureau of Land  
Management or by a decree of a Court of Law and/or that the corner points mentioned in lines 3, 4 and 5  
above were in conformance with the rules of the Michigan Board of Land Surveyors or by a Decree of a  
Court of Law; established, re-established, monumented, re-monumented, recovered, found as  
restored below:

**NOTE: Not more than 4 corners, all in the same town and range, may be recorded  
on this certificate.**

Description of original monument and accessories and/or subsequent restoration:

- 7-GLO Wampler, D.S.; Set Post; 30" Black Oak N75°E 11 Links; 10" White Oak S76°W 49 Links
- 1974-Kobs, P.S. #14097; LCRC L.2534, Pg.481 - Fnd 3/8" Iron Bar
- 1980-Coulter, P.S. #14760; LCRC L.3295, Pg.801 - Fnd 1/2" Re-rod
- 1987-King, P.S. #30085; LCRC L.4151, Pg.128 - Fnd 1/2" Iron Bar
- 1986-Avey, P.S. #30076; LCRC L.4080, Pg.889 - Fnd 1/2" Bar as previously recorded
- 1974-Kobs, P.S. #14097; Survey L.2534, Pg.455 - Fnd 3/8" Iron Bar
- 1974-Kobs, P.S. #14097; Survey L.2534, Pg.456 - Fnd 3/8" Iron Bar, used same wit as 1974 Survey
- 1991-Kobs, P.S. #14097; Survey L.5224, Pg.128 - Fnd 1/2" Iron in pavement
- 1991-Kobs, P.S. #14097; Survey L.5224, Pg.129 - Fnd 1/2" Iron in pavement, used same wit as 1991 Survey
- 1991-Kobs, P.S. #14097; Survey L.5224, Pg.130 - Fnd 1/2" Iron in pavement, used same wit as 1991 Survey

Description of corner evidence found and/or method applied in restoring or reestablishing corner:

- 4 Kennedy Surveying, Inc. - Kennedy, P.S. #17623 - Fnd 1/2" Iron Rod 2" deep and 2.5 feet North of the centerline of 30 Mile Road, which has a bituminous surface and in the centerline of Kildare Road extending to the South, which has a gravel surface.

Witnesses from LCRC #1, 2, 3, 4 and Survey #5 & 7 were used to recover and verify the location of the found 1/2" Iron.

**FIELD MEASUREMENT BETWEEN**

- H-5 to G-5 2557.60 Feet
- H-5 to I-5 2643.38 Feet

ACCEPTED BY THE MACOMB COUNTY SURVEY PEER  
GROUP AS THE OFFICIAL CORNER UNDER MICHIGAN  
PUBLIC ACT 345 OF 1980 AT A MEETING HELD  
ON 9-20-94  
William E. Soderberg  
WILLIAM E. SODERBERG, P.S., CHAIRMAN

Description of monument for corner and accessories established to perpetuate locating the position of the corner:

- I replaced the 1/2" Iron Rod with a 3/4" x 24" Iron Rod w/2" diameter aluminum cap stamped "Macomb County Monument Act 345 #17623" in a new Monument Box.
- N16°E 38.06' Set PK & Remon. Washer in SW face 4" Maple
- S84°W 92.27' Set PK & Remon. Washer North face 23" Maple
- S46°W 39.70' Set PK & Remon. Washer SE face Power Pole
- S44°E 111.34' NW corner house #11008

selected location is accepted by me and is generally accepted by Professional Surveyors as the best available evidence of the  
location of the original corner.



Set by [Signature] Date September 20, 1994  
Surveyor's Michigan License No. 17623