

**LAND CORNER RECORDATION CERTIFICATE**  
 Filing Requirement of Act 74, Mich. P.A. 1970

For corners in  
Macomb  
 (County)

Located In: Washington Twp  
 Corner Code # \_\_\_\_\_

**SURVEY &  
 REMONUMENTATION**  
  
 FEB 27 1997  
  
 COMMISSION  
  
 Register of Deeds Stamp & File Number

1. Public Land Survey

|   |          |   |            |       |
|---|----------|---|------------|-------|
| T | <u>4</u> | R | <u>12E</u> | I-4   |
| T | _____    | R | _____      | _____ |
| T | _____    | R | _____      | _____ |
| T | _____    | R | _____      | _____ |
| S | _____    | T | _____      | _____ |
| S | _____    | T | _____      | _____ |
| S | _____    | T | _____      | _____ |
| S | _____    | T | _____      | _____ |

2. Property Controlling in Section


3. Miscellaneous Property in Sec.

4. Lot No. \_\_\_\_\_, Recorded Plat \_\_\_\_\_

5. Private Claims \_\_\_\_\_

I, Huston K. Kennedy, in a field survey on April 12 1996 do hereby state that under requirements of P.A. 74, Michigan P.A. of 1970, the corner points mentioned in lines 1 and 2 above were in conformance with regulations and rules therefore as required in the current manual of survey instructions of the United States Department of the Interior, Bureau of Land Management or by a decree of a Court of Law and/or that the corner points mentioned in lines 3, 4 and 5 above were in conformance with the rules of the Michigan Board of Land Surveyors or by a Decree of a Court of Law; established, re-established, monumented, recovered, found as expressed below:

NOTE: Not more than 2 corners, all in the same town and range, may be recorded on this certificate.

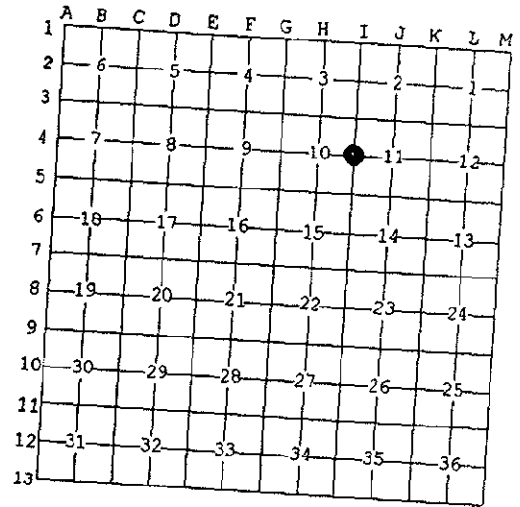

ACCEPTED BY THE MACOMB COUNTY SURVEY PE GROUP AS THE OFFICIAL CORNER UNDER MICHIGAN PUBLIC ACT 345 OF 1990 AT A MEETING HE ON Feb 21 1997  
William E. Soderberg  
 WILLIAM E. SODERBERG, P.S., CHAIRMAN

A. Description of original monument and accessories and/or subsequent restoration:

- 1817-GLO Wampler, D.S.; Set Post 6" White Oak S41°W 60 Links
- 1.) 1975-Nelson, PS #21273; LCRC L.2609, Pg.146 - Fnd 1" Iron Pipe
- 2.) 1986-Kobs, PS #14097; LCRC L.3880, Pg.121 - Fnd 1" Pipe
- 3.) 1990-Kobs, PS #14097; LCRC L.4924, Pg.675 - Reset 1/2" Iron & Cap #14097
- 4.) 1985-Kobs, PS #14097; Survey L.3880, Pg.42 - Fnd 1" Pipe, used same wit as 1986 LCRC

B. Description of corner evidence found and/or method applied in restoring or reestablishing corner:

1996 Kennedy Surveying, Inc. - Kennedy, PS #17623 - Fnd 1/2" Iron Rod w/cap 4" deep with a tree-fence row extending to the North & South. Also the North line of the Detroit Edison Right-of-Way and 15 feet ± East of a North-South drive in a Apple Orchard marked with a 6" x 6" x 10' post.

Witnesses from LCRC #2 & 3 were used to recover and verify the location of the found 1/2" Iron Rod w/cap.

FIELD MEASUREMENTS BETWEEN

- I-4 to I-3 GLO = 40 chains or 2640.00 Ft. & 2596.27 Ft. (GPS-NEA)
- I-4 to I-5 GLO = 40 chains or 2640.00 Ft. & 2593.33 Ft. (GPS-NEA)
- I-4 to I-5 2593.18 Ft., L.2880, Pg.42


C. Description of monument for corner and accessories established to perpetuate locating the position of the corner:

- I-4 I replaced the found 1/2" Iron Rod w/cap with a 3/4" x 24" Iron Rod w/2" diameter aluminum cap stamped "Macomb County Monument MI Act 345" #17623
- S71°W 59.15' Set PK & Remon Washer NW face 13" Apple
- S28°E 56.20' Top Nut of Gas Stand Pipe
- N37°W 67.02' Set PK & Remon Washer SW face 4" Apple
- N46°E 26.70' Set PK & Remon Washer SE face 5" Box Elder

The selected location is accepted by me and is generally accepted by Professional Surveyors as the best available evidence of the position of the original corner.

Signed by [Signature]  
 Surveyor's Michigan License No. 17623

Date 12-6-96

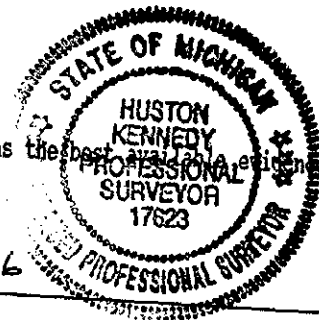

629