SURVEY &
REMONUMENTATION

APR 2 8 1995

COMMISSION

C126151

94 SEP 30 AM 9:00

CARMEL[illegible]AUGH
REGISTER OF DEEDS
MACOMB COUNTY, MI

LAND CORNER RECORDATION CERTIFICATE

Filing Requirement of Act 74, Mich. P.A. 1970

For corner: Macomb (County)

Located In: Washington Township

Corner Code #

1. Public Land Survey — T 4N R 12E — I-8
   T ___ R ___
   T ___ R ___
   T ___ R ___
2. Property Controlling — S ___ T ___ R ___
   in Section — S ___ T ___ R ___
3. Miscellaneous — S ___ T ___ R ___
   Property in Sec. — S ___ T ___ R ___

LIBER 06464 PG 464

Register of Deeds Stamp & File Number

4. Lot No. _____, Recorded Plat _____
5. Private Claims _____

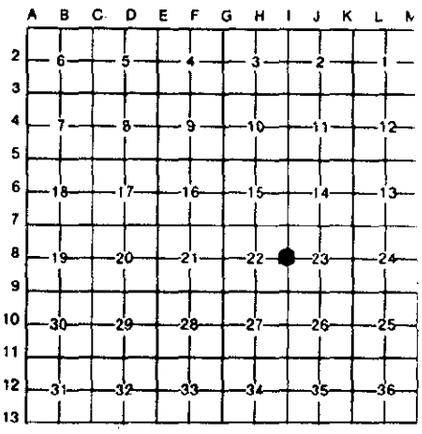

I, Huston K. Kennedy in a field survey on August 21, 19 94, do hereby certify that under requirements of P.A. 74, Michigan P.A. of 1970, the corner points mentioned in lines 1 and 2 above were in conformance with regulations and rules therefore as required in the current manual of survey instructions of the United States Department of the Interior, Bureau of Land Management or by a decree of a Court of Law and/or that the corner points mentioned in lines 3, 4 and 5 above were in conformance with the rules of the Michigan Board of Land Surveyors or by a Decree of a Court of Law; established, re-established, monumented, re-monumented, recovered, found as expressed below:

NOTE: Not more than 4 corners, all in the same town and range, may be recorded on this certificate.

A. Description of original monument and accessories and/or subsequent restoration:

1817-GLO Wampler, D.S.; Set Post 12" Elm N23°E 13 Links; 16" Lynn S37 1/2°W 7 Links
1.) 1982-Kobs, P.S. #14097; LCRC L.3421, Pg.531 - Fnd 1/2" Iron Bar in a Monument Box
2.) 1986-Avey, P.S. #30076; LCRC L.4080, Pg.890 - Fnd 1/2" Bar in a Monument Box
3.) 1990-King, P.S. #30085; Survey L.4866, Pg.832 - Fnd 1/2" Iron in a Monument Box, used same wit as 1982 LCRC

B. Description of corner evidence found and/or method applied in restoring or reestablishing corner:

1994 Kennedy Surveying, Inc. - Kennedy, P.S. #17623 - fnd 1/2" Iron Rod in a Monument Box 4' West of the centerline of Jewell Road, which has a bituminous surface, a tree-fence row extending to the East & West, and 13' South of driveway for house #62025.

Witnesses from LCRC #1 & 2 were used to recover and verify the location of the found 1/2" Iron Rod in a Monument Box.

FIELD MEASUREMENT BETWEEN

I-8 to I-7 2648.35 Feet
I-8 to I-9 2487.84 Feet

ACCEPTED BY THE MACOMB COUNTY SURVEY PEER GROUP AS THE OFFICIAL CORNER UNDER MICHIGAN PUBLIC ACT 345 OF 1990 AT A MEETING HELD ON 8-30-94

William E. Soderberg
WILLIAM E. SODERBERG, P.S., CHAIRMAN

C. Description of monument for corner and accessories established to perpetuate locating the position of the corner:

I-8 I replaced the found 1/2" Iron Rod in a Monument Box with a 3/4" x 24" Iron Rod w/2" diameter aluminum cap stamped "Macomb County Monument MI Act 345 #17623" in a existing Monument Box.
N64°E 45.50' Set PK & Remon. Washer NW face Power Pole
N31°E 113.63' Set PK & Remon. Washer NW face Guide Pole
N40°W 72.84' Set PK & Remon. Washer SW face 28" Ash
N57°W 42.65' Set PK & Remon. Washer SW face Guide Pole

The selected location is accepted by me and is generally accepted by Professional Surveyors as the best available evidence of the position of the original corner.

STATE OF MICHIGAN
HUSTON KENNEDY
PROFESSIONAL SURVEYOR
17623
LICENSED PROFESSIONAL SURVEYOR

Signed by _____ Date August 30, 1994

Surveyor's Michigan License No. 17623

FORM APPROVED BY MICHIGAN STATE BOARD OF LAND SURVEYORS, JAN. 28, 1971
REVISED MAY 14, 1975
REVISED JAN., 1983