


LAND CORNER RECORDATION CERTIFICATE
 Filing Requirement of Act 74, Mich. P.A. 1970

For corners in
Macomb
 (County)

Located In: Washington Twp
 Corner Code #

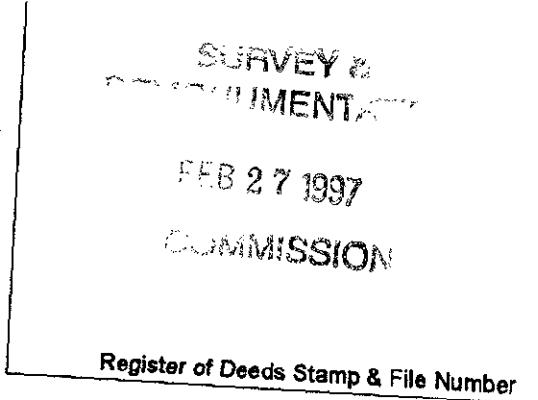

1. Public Land Survey	T <u>4N</u> R <u>12E</u>	J-3
	T ___ R ___	_____
	T ___ R ___	_____
	T ___ R ___	_____
2. Property Controlling in Section	S ___ T ___ R ___	_____
	S ___ T ___ R ___	_____
3. Miscellaneous Property in Sec.	S ___ T ___ R ___	_____
	S ___ T ___ R ___	_____

4. Lot No. _____, Recorded Plat _____
 5. Private Claims _____

I, Huston K. Kennedy, in a field survey on April 12, 1996 do hereby state that under requirements of P.A. 74, Michigan P.A. of 1970, the corner points mentioned in lines 1 and 2 above were in conformance with regulations and rules therefore as required in the current manual of survey instructions of the United States Department of the Interior, Bureau of Land Management or by a decree of a Court of Law and for that the corner points mentioned in lines 3, 4 and 5 above were in conformance with the rules of the Michigan Board of Land Surveyors or by a Decree of a Court of Law; established, re-established, monumented, recovered, found as expressed below:

NOTE: Not more than 2 corners, all in the same town and range, may be recorded on this certificate.

1	A	B	C	D	E	F	G	H	I	J	K	L	M
2	6		5		4		3		2		1		
3													
4	7		8		9		10		11		12		
5													
6	18		17		16		15		14		13		
7													
8	19		20		21		22		23		24		
9													
10	30		29		28		27		26		25		
11													
12	31		32		33		34		35		36		
13													

A. Description of original monument and accessories and/or subsequent restoration:

- 1817-GLO Wampler, D.S.; Set Post - No Witnesses
- 1.) 1975-Nelson, PS #21273; LCRC L.2609, Pg.144 - Fnd 1/2" Iron
- 2.) 1981-Kobs, PS #14097; LCRC L.3355, Pg.491 - Fnd 3/4" Iron Bar
- 3.) 1995-King, PS #30085; Survey L.6628, Pg.20 - Fnd 1/2" Iron Bar w/cap #30085

ACCEPTED BY THE MACOMB COUNTY SURVEY PEER GROUP AS THE OFFICIAL CORNER UNDER MICHIGAN PUBLIC ACT 345 OF 1990 AT A MEETING HELD ON 7-23-96

William E. Soderberg
 WILLIAM E. SODERBERG, P.S., CHAIRMAN

B. Description of corner evidence found and/or method applied in restoring or reestablishing corner:
 1996 Kennedy Surveying, Inc. - Kennedy, PS #17623 - I recovered 1/2" Iron Pipe at the surface 3 feet North of the existing centerline of 31 Mile Road extending to the East & West, which has a gravel surface and 225 feet West of railroad tracks crossing. I also found a 1/2" Iron Rod 2.98 feet to the East.

Witnesses from LCRC #1 & 2 and Survey #3 were used to recover and verify the location of the found 1/2" Iron Pipe.

FIELD MEASUREMENTS BETWEEN

- J-3 to I-3 39.40 chains or 2600.40 Ft., 2706.63 Ft. (GPS-MEA)
- J-3 to I-3 2705.78 Ft., L.6628, Pg.20
- J-3 to K-3 39.40 chains or 2600.40 Ft., 2663.69ft. (GPS-MEA)
- J-3 to K-3 2664.00 Ft. L.6628, Pg.20
- J-3 to K-3 2664.51 Ft. (M.D.O.T.)

C. Description of monument for corner and accessories established to perpetuate locating the position of the corner:
 J-3 I replaced the found 1/2" Iron Pipe with a 3/4" x 24" Iron Rod w/2" diameter aluminum cap stamped "Macomb County Monument MI Act 345" #17623

- S78°W 152.87' Set PK & Remon Washer NW face Guide Pole
- N81°W 124.02' Set PK & Remon Washer South face Power Pole
- S59°W 67.61' Set PK & Remon Washer North face Power Pole
- S75°E 142.98' Set PK & Remon Washer North face Power Pole
- East 2.98 feet 1/2" Iron Rod

The selected location is accepted by me and is generally accepted by Professional Surveyors as the best available evidence of the position of the original corner.

Signed by [Signature]
 Surveyor's Michigan License No. 17623

Date 12-6-96

