SURVEY & REMONUMENTATION

APR 2 9 1996

COMMISSION

C0210473 LIBER:06660 PAGE:208 12:39P 06/01/1995
CARMELLA SABAUGH-MACOMB COUNTY, MI REG/DEEDS

LAND CORNER RECORDATION CERTIFICATE

Filing Requirement of Act 74, Mich. P.A. 1970

For corners in Macomb (County) Located In: Washington Twp. Corner Code #

APR 0 8 1996

Register of Deeds Stamp & File Number

1. Public Land Survey T 4N R 12E J-5
2. Property Controlling in Section
3. Miscellaneous Property in Section

4. Lot No. _____, Recorded Plat _____
5. Private Claims _____

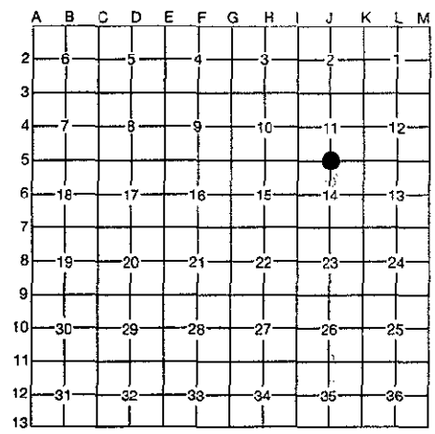

I, Huston K. Kennedy in a field survey on April 28, 19 95, do hereby certify that under requirements of P.A. 74, Michigan P.A. of 1970, the corner points mentioned in lines 1 and 2 above were in conformance with regulations and rules therefore as required in the current manual of survey instructions of the United States Department of the Interior, Bureau of Land Management or by a decree of a Court of Law and/or that the corner points mentioned in lines 3, 4 and 5 above were in conformance with the rules of the Michigan Board of Professional Surveyors or by a Decree of a Court of Law; established, re-established, monumented, re-monumented, recovered, found as expressed below:

NOTE: Not more than 4 corners, all in the same town and range, may be recorded on this certificate.

A. Description of original monument and accessories and/or subsequent restoration:

1817-GLO Wampler, D.S.; Set Post 11" Red Oak N55°E 28 Links; 24" Red Oak N36°W 25 Links
1.) 1975-Nelson, PS #21273; LCRC L.2588, Pg. 297 - Fnd 1/2" Re-rod
2.) 1979-McMahon, PS #4018; LCRC L.3106, Pg. 513 - Fnd 1/2" Re-bar
3.) 1986-Kobs, PS #14097; LCRC L.3880, Pg. 121 - Fnd 1/2" Iron Bar
4.) 1975-Nelson, PS #21273; Survey L.2588, Pg. 293 - Fnd Iron
5.) 1978-Nelson, PS #21273; Survey L.2944, Pg. 164 - Fnd Iron
6.) 1978-Nelson, PS #21273; Survey L.2944, Pg. 165 - Fnd Iron
7.) 1978-Nelson, PS #21273; Survey L.2944, Pg.168 - Fnd Iron
8.) 1995-King, PS #30085; Unrecorded Survey - Fnd 1/2" Boat Spike
9.) 1995-King, PS #30085; Unrecorded LCRC - Fnd 1/2" Boat Spike, used same wit as first unrecorded survey

ACCEPTED BY THE MACOMB COUNTY SURVEY PEER GROUP AS THE OFFICIAL CORNER UNDER MICHIGAN PUBLIC ACT 345 OF 1990 AT A MEETING HELD ON MAY 23, 1995

WILLIAM E. SODERBERG, P.S., CHAIRMAN

B. Description of corner evidence found and/or method applied in restoring or reestablishing corner:

1995 Kennedy Surveying, Inc. - Kennedy, PS #17623 - Fnd 1/2" Iron Rod 5" deep and 3 feet South of the centerline of 30 Mile Road extending to the East & West and has a gravel surface with a tree-fence row extending North & South.

Witnesses from LCRC #1, 2 & 3 were used to recover and verify the location of the found 1/2" Iron Rod.

FIELD MEASUREMENTS BETWEEN

J-5 to I-5 2733.48 Ft. GLO = 40.75 chains or 2689.50 Ft.
J-5 to K-5 2553.29 Ft. GLO = 40.75 chains or 2689.50 Ft.

C. *Description of monument for corner and accessories established to perpetuate locating the position of the corner:*

J-5 I replaced the found 1/2" Iron Rod with a 3/4" x 24" Iron Rod w/2" diameter aluminum cap stamped "Macomb County Monument MI Act 345 #17623"
Due North 34.00' Set PK & Remon. Washer West face Power Pole
N38°E 40.33' Set PK & Remon. Washer SE face 9" Elm
S26°W 31.80' Set PK & Remon. Washer NW face 19" Box Elder
S52°W 47.75' Set PK & Remon. Washer NW face 21" Box Elder

The selected location is accepted by me and is generally accepted by Professional Surveyors as the best available evidence of the position of the original corner.

STATE OF MICHIGAN HUSTON KENNEDY PROFESSIONAL SURVEYOR 17623 LICENSED PROFESSIONAL SURVEYOR

Signed by _____ Date May 24, 1995

Surveyor's Michigan License No. 17623

FORM APPROVED BY MICHIGAN STATE BOARD OF PROFESSIONAL SURVEYORS, JAN. 28, 1971
REVISED MAY 14, 1975
REVISED JAN. 1982