

LAND CORNER RECORDATION CERTIFICATE
Filing Requirement of Act 74, Mich. P.A. 1970

For corners in

Washington Twp.

Macomb

Located In:

Corner Code #

(County)

1. Public Land Survey	T <u>4</u> N	R <u>12</u> E	<u>K-1</u>
	T <u> </u>	R <u> </u>	<u> </u>
	T <u> </u>	R <u> </u>	<u> </u>
	T <u> </u>	R <u> </u>	<u> </u>
2. Property Controlling in Section	S <u> </u>	T <u> </u>	R <u> </u>
	S <u> </u>	T <u> </u>	R <u> </u>
3. Miscellaneous Property in Sec.	S <u> </u>	T <u> </u>	R <u> </u>
	S <u> </u>	T <u> </u>	R <u> </u>

**SURVEY &
REMONUMENTATION**

FEB 27 1997

COMMISSION

Register of Deeds Stamp & File Number

4. Lot No. _____, Recorded Plat _____
 5. Private Claims _____

I, Huston K. Kennedy, in a field survey on May 1, 1996 do hereby state that under requirements of P.A. 74, Michigan P.A. of 1970, the corner points mentioned in lines 1 and 2 above were in conformance with regulations and rules therefore as required in the current manual of survey instructions of the United States Department of the Interior, Bureau of Land Management or by a decree of a Court of Law and/or that the corner points mentioned in lines 3, 4 and 5 above were in conformance with the rules of the Michigan Board of Land Surveyors or by a Decree of a Court of Law, established, re-established, monumented, recovered, found as expressed below:

NOTE: Not more than 2 corners, all in the same town and range, may be recorded on this certificate.

A	B	C	D	E	F	G	H	I	J	K	L	M
1												
2	6	5	4	3	2							
3												
4	7	8	9	10	11	12						
5												
6	18	17	16	15	14	13						
7												
8	19	20	21	22	23	24						
9												
10	30	29	28	27	26	25						
11												
12	31	32	33	34	35	36						
13												

A. Description of original monument and accessories and/or subsequent restoration:

1817-GLO Wampler, D.S.; Set Post 8" Beech N61°W 12 Links; 16" Beech S26°E 6 Links
 1.) 1980-Miller, PS #13589; LCRC L.3288, Pg.635 - Fnd Discon Copperclad Rod
 2.) 1979-Alloway, PS #12043; Survey L.3127; Pg.751 - Fnd Iron Pipe

ACCEPTED BY THE MACOMB COUNTY SURVEY PEER GROUP AS THE OFFICIAL CORNER UNDER MICHIGAN PUBLIC ACT 345 OF 1990 AT A MEETING HELD ON 8-20-96.

William E. Soderberg
 WILLIAM E. SODERBERG, P.S., CHAIRMAN

B. Description of corner evidence found and/or method applied in restoring or reestablishing corner:

1996 Kennedy Surveying, Inc. - Kennedy, PS #17623 - With the construction and widening of the intersection of M-53 & 32 Mile Road all witnesses were removed and the corner was not reset. (over)

FIELD MEASUREMENTS BETWEEN

K-1 to J-1 2685.79 Ft. (GPS-MEA) & 2685.65 Ft., L.3127, Pg.751
 K-1 to K-2 GLO = 48.17 chains or 3179.22 Ft., 3164.12 Ft. (M.DOT) & 3158.48 Ft. (GPS-MEA)
 K-1 to K-13 GLO = 1.24 chains or 81.84 Ft., 42.87 Ft., L.3127, Pg.751 & M.DOT
 K-1 to L-1 No GLO, 2748.03 Ft. (GPS-MEA)


C. Description of monument for corner and accessories established to perpetuate locating the position of the corner:

K-1 I set a 3/4" x 24" Iron Rod w/2" diameter aluminum cap stamped "Macomb County Monument MI Act 345" #17623 in a new Monument Box.
 N38°E 79.32' Set PK & Remon Washer NW face 13" Ash
 N72°W 197.59' Set PK & Remon Washer South face Guide Pole
 S65°W 171.99' Set PK & Remon Washer NW face Power Pole
 S28°E 72.65' Set PK & Remon Washer NE face Power Pole
 West 42.87 feet corner common to Sections 35 & 36, T5N, R12E, Bruce Twp., (K-13) Iron in a Monument Box

The selected location is accepted by me and is generally accepted by Professional Surveyors as the best available evidence position of the original corner.

Signed by *[Signature]*
 Surveyor's Michigan License No. 17623

Date 12-6-96

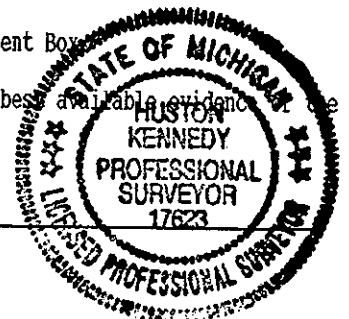

628