

LAND CORNER RECORDATION CERTIFICATE
Filing Requirement of Act 74, Mich. P.A. 1970

For corners in

Macomb
 (County)

Located In: Washington Twp Corner Code #

- | | | | |
|------------------------------------|--------------|---------------|------------|
| 1. Public Land Survey | T <u>4</u> N | R <u>12</u> E | <u>K-3</u> |
| | T _____ | R _____ | _____ |
| | T _____ | R _____ | _____ |
| | T _____ | R _____ | _____ |
| 2. Property Controlling in Section | S _____ | T _____ | R _____ |
| | S _____ | T _____ | R _____ |
| 3. Miscellaneous Property in Sec. | S _____ | T _____ | R _____ |
| | S _____ | T _____ | R _____ |

**SURVEY &
 REMONUMENTATION**

FEB 27 1997

COMMISSION

Register of Deeds Stamp & File Number

4. Lot No. _____, Recorded Plat _____
 5. Private Claims _____

I, Huston K. Kennedy, in a field survey on April 12, 1996 do hereby state that under requirements of P.A. 74, Michigan P.A. of 1970, the corner points mentioned in lines 1 and 2 above were in conformance with regulations and rules therefore as required in the current manual of survey instructions of the United States Department of the Interior, Bureau of Land Management or by a decree of a Court of Law and/or that the corner points mentioned in lines 3, 4 and 5 above were in conformance with the rules of the Michigan Board of Land Surveyors or by a Decree of a Court of Law; established, re-established, monumented, recovered, found as expressed below:

NOTE: Not more than 2 corners, all in the same town and range, may be recorded on this certificate.

	A	B	C	D	E	F	G	H	I	J	K	L	M
1													
2	6			5			4			3			1
3													
4	7			8			9			10			12
5													
6	18			17			16			15			13
7													
8	19			20			21			22			24
9													
10	30			29			28			27			25
11													
12	31			32			33			34			36
13													

A. Description of original monument and accessories and/or subsequent restoration:

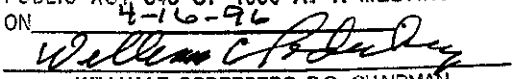
- 1817-GLO Wampler, D.S.; Set Post 10" Ironwood N58°E 16 Links, 8" Sugar S22°W 12 Links
 1.) 1972-Melching, PS #14767; LCRC L.2259, Pg.808 - Fnd 3/8" Diameter Rod
 2.) 1973-Avendt, Jr., PS #16034; LCRC L.2420, Pg.643 - Fnd 1/2" Iron Rod in a Monument Box
 3.) 1977-Kobs, PS #14097; LCRC L.2775, Pg.798 - Fnd 1/2" Iron Bar
 4.) 1988-Kobs, PS #14097; LCRC L.4543, Pg.59 - Fnd 1/2" Smooth Iron
 5.) 1972-Melching, PS #14767, Survey L.2259, Pg.827 - Fnd Iron, used same wit as 1972 LCRC
 6.) 1979-Avendt, Jr., PS #16034; Survey L.3123, Pg.265 - Fnd 1/2" Iron, used same wit as 1973 LCRC
 7.) 1979-Smith, PS #16052; Survey L.3168, Pg.971- Fnd 1/2" Iron, used same wit as 1973 LCRC
 8.) 1980-Smith, PS #16052; Survey L.3216, Pg.534 - Fnd 1/2" Iron, used same wit as 1973 LCRC
 9.) 1980-Smith, PS #16052; Survey L.3216, Pg.527 - Fnd 1/2" Iron, used same wit as 1973 LCRC

B. Description of corner evidence found and/or method applied in restoring or reestablishing corner:

1996 Kennedy Surveying, Inc. - Kennedy, PS #17623 - Fnd 1/2" Iron Rod 2" below the surface, 2 feet North of the existing centerline of 31 Mile Road extending to the East & West, which has a gravel surface and is 9 feet West of the driveway for house #13616. A fence-tree line extending to the South.

Witnesses from LCRC 1, 3 & 4 were used to recover and verify the location of the found 1/2" Iron Rod

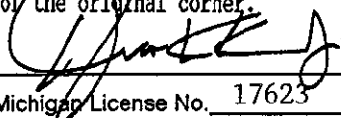
Field Measurements see back side of LCRC

ACCEPTED BY THE MACOMB COUNTY SURVEY PEER GROUP AS THE OFFICIAL CORNER UNDER MICHIGAN PUBLIC ACT 345 OF 1990 AT A MEETING HELD ON 4-16-96

 WILLIAM E. SODERBERG, P.S., CHAIRMAN

C. Description of monument for corner and accessories established to perpetuate locating the position of the corner:

- K-3 I replaced the found 1/2" Iron Rod with a 3/4" x 24" Iron Rod w/2" diameter aluminum cap stamped "Macomb County Monument MI Act 345" #17623
 N65°W 69.00' Set PK & Remon Washer SW face Power Pole
 N61°E 66.40' Set PK & Remon Washer South face 37" Maple
 S03°E 108.04' Set PK & Remon Washer West face Power Pole
 N43°W 74.37' Set PK & Remon Washer SW face 36" Maple

The selected location is accepted by me and is generally accepted by Professional Surveyors as the best available evidence of the position of the original corner.

Signed by  _____
 Surveyor's Michigan License No. 17623

Date 12-6-96



589

29

FIELD MEASUREMENTS BETWEEN

K-3 to J-3 GLO = 39.40 chains or 2600.40	K-3 to K-2 GLO = 40 chains or 2640.00 Ft.	K-3 to K-4 2564.34 Ft. L.5390, Pg.277
K-3 to J-3 2664.00 Ft. L.6628, Pg.20	K-3 to K-2 2671.09 Ft. M.D.O.T.	K-3 to L-3 GLO = 40.43 chains or 2668.38 Ft.
K-3 to J-3 1998.00 Ft. L.5390, Pg.227	K-3 to K-2 2670.70 Ft. (GPS-MEA)	K-3 to L-3 2715.10 Ft. L.2259, Pg.827
K-3 to J-3 2664.51 Ft. M.D.O.T.	K-3 to K-4 GLO = 40 chains or 2640.00 Ft.	K-3 to L-3 2714.94 Ft. L.5969, Pg.147
K-3 to J-3 2663.69 Ft. (GPS-MEA)	K-3 to K-4 2563.07 Ft. M.D.O.T.	K-3 to L-3 2714.59 Ft. (GPS-MEA)

C0458180 LIBER:07298 PAGE:211 10:47A 01/02/1997
CARMELLA SABAUGH-MACOMB COUNTY, MI REG/DEEDS

SURVEY &
REMONUMENTATION

FEB 27 1997

COMMISSION