

SURVEY & REMONUMENTATION

APR 29 1995

COMMISSION

C0210474 LIBER:06660 PAGE:209 12:39P 06/01/1995
 CARMELLA SABAUGH-MACOMB COUNTY, MI REG/DEEDS

LAND CORNER RECORDATION CERTIFICATE
Filing Requirement of Act 74, Mich. P.A. 1970

For corners in Macomb Located In: Washington Corner Code #
 (County) Twp.

- | | | | | | |
|--------------------------------------|---|-----------|---|------------|------------|
| 1. Public Land Survey | T | <u>4N</u> | R | <u>12E</u> | <u>K-6</u> |
| | T | | R | | |
| | T | | R | | |
| | T | | R | | |
| 2. Property Controlling in Section | S | | T | | |
| | S | | T | | |
| 3. Miscellaneous Property in Section | S | | T | | |
| | S | | T | | |

Register of Deeds Stamp & File Number

4. Lot No. _____, Recorded Plat _____
 5. Private Claims _____

A	B	C	D	E	F	G	H	I	J	K	L	M
2	6	5	4	3	2	1						
3												
4	7	8	9	10	11	12						
5												
6	18	17	16	15	14	13						
7												
8	19	20	21	22	23	24						
9												
10	30	29	28	27	26	25						
11												
12	31	32	33	34	35	36						
13												

I, Huston K. Kennedy, in a field survey on April 28, 19 95, do hereby certify that under requirements of P.A. 74, Michigan P.A. of 1970, the corner points mentioned in lines 1 and 2 above were in conformance with regulations and rules therefore as required in the current manual of survey instructions of the United States Department of the Interior, Bureau of Land Management or by a decree of a Court of Law and/or that the corner points mentioned in lines 3, 4 and 5 above were in conformance with the rules of the Michigan Board of Professional Surveyors or by a Decree of a Court of Law; established, re-established, monumented, re-monumented, recovered, found as expressed below:

NOTE: Not more than 4 corners, all in the same town and range, may be recorded on this certificate.

A. Description of original monument and accessories and/or subsequent restoration:

- 1817-GLO Wampler, D.S.; Set Post 12" Sassafras N84°W 9 Links; 9" Sassafras S42°E 8 Links
- 1975-Nelson, PS #21273; LCRC L.2588, Pg.295 - Fnd 1/2" Re-rod
 - 1983-Kobs, PS #14097; LCRC L.3465, Pg.182 - Fnd 1/2" Iron Bar at Anchor Post
 - 1974-Kobs, PS #14097; Survey L.2466, Pg.724 - Fnd 1/2" Iron Bar at Anchor Post
 - 1974-Kobs, PS #14097; Survey L.2474, Pg.836 - Fnd 1/2" Iron Bar at Anchor Post, used same wit as (3) first recorded survey
 - 1975-Nelson, PS #21273; Survey L.2588, Pg.293 - Fnd Iron Pipe
 - 1977-Kobs, PS #14097; Survey L.2762, Pg.28 - Fnd 1/2" Iron Bar at Anchor Post, used same wit as (3) first recorded survey
 - 1983-Kobs, PS #14097; Survey L.3465, Pg.180 - Fnd 1/2" Iron Bar at Anchor Post, used same wit as 1983 LCRC


B. Description of corner evidence found and/or method applied in restoring or reestablishing corner:

1995 Kennedy Surveying, Inc. - Kennedy, PS #17623 - Fnd 1/2" Iron Rod 6" deep at base of an old wooden fence post with a fence-rock row extending to the East & West, and a fence, tree & rock row extending to the North & South.

Witnesses from LCRC #1, 2 and Survey #3 were used to recover and verify the location of the found 1/2" Iron Rod.

FIELD MEASUREMENTS BETWEEN

- K-5 to J-5 2553.29 Ft., GLO = 40.75 chains or 2689.50 Ft.
- K-5 to L-5 2734.00 Ft., GLO = 39.72 chains or 2621.52 Ft.
- K-5 to K-6 2783.40 Ft., GLO = 40.00 chains or 2640.00 Ft.

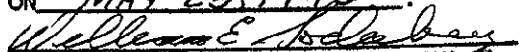
ACCEPTED BY THE MACOMB COUNTY SURVEY PEER GROUP AS THE OFFICIAL CORNER UNDER MICHIGAN PUBLIC ACT 345 OF 1990 AT A MEETING HELD ON MAY 23, 1995

 WILLIAM E. SODERBERG, P.S., CHAIRMAN

C. Description of monument for corner and accessories established to perpetuate locating the position of the corner:

- K-6 I replaced the found 1/2" Iron Rod with a 3/4" x 24" Iron Rod w/2" diameter aluminum cap stamped "Macomb County Monument MI Act 345 #17623
- N47°E 10.89' Set PK & Remon. Washer North face 13" Ash
 - S33°E 30.33' Set PK & Remon. Washer NE face 12" Ash
 - S04°E 30.96' Set PK & Remon. Washer West face 23" Thorn Apple
 - S22°W 18.75' Set PK & Remon. Washer East face 9" Ash

The selected location is accepted by me and is generally accepted by Professional Surveyors as the best available evidence of the position of the original corner.

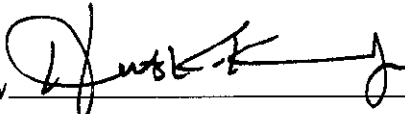

Signed by 
 Surveyor's Michigan License No. 17623

Date May 24, 1995