

SURVEY & REMONUMENTATION

C126153

APR 28 1995

LAND CORNER RECORDATION CERTIFICATE

94 SEP 30 AM 9:00

For corners in **COMMISSION**
Macomb
(County)

Filing Requirement of Act 74, Mich. P.A. 1970

CARMELLA BAUGH
 REGISTER OF DEEDS
 MACOMB COUNTY, MI


Washington
 Located In: Washington Township Corner Code ≠

1. Public Land Survey	T	<u>4N</u>	R	<u>12E</u>	<u>K-7</u>
	T		R		
	T		R		
	T		R		
	T		R		
2. Property Controlling in Section	S		T		
	S		T		
3. Miscellaneous Property in Sec.	S		T		
	S		T		

06464PC466

Register of Deeds Stamp & File Number

4. Lot No. _____, Recorded Plat _____
 5. Private Claims _____

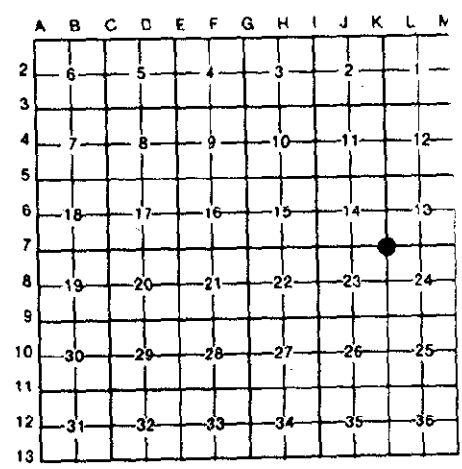

I, Huston K. Kennedy, in a field survey on August 21, 19 94, do hereby certify that under requirements of P.A. 74, Michigan P.A. of 1970, the corner points mentioned in lines 1 and 2 above were in conformance with regulations and rules therefore as required in the current manual of survey instructions of the United States Department of the Interior, Bureau of Land Management or by a decree of a Court of Law and/or that the corner points mentioned in lines 3, 4 and 5 above were in conformance with the rules of the Michigan Board of Land Surveyors or by a Decree of a Court of Law, established, re-established, monumented, recovered, found as expressed below:

NOTE: Not more than 4 corners, all in the same town and range, may be recorded on this certificate.

A. Description of original monument and accessories and/or subsequent restoration:

- 1817-GLO Wampler, D.S.; Set Post; 26" Elm N53°W 9 Links; 10" Hickory S52°E 8 Links
- 1.) 1983-Kobs, P.S. #14097; LCRC L.3465, Pg.182 - Fnd "T" Iron in pavement
 - 2.) 1988-Avey, P.S. #15396; LCRC L.4353, Pg.439 - Fnd 1/2" Bar
 - 3.) 1989-Avey, P.S. #15396; LCRC L.4584, Pg.239 - Fnd "T" Bar, used same wit as 1988 LCRC
 - 4.) 1975-Kobs, P.S. #14097; Survey L.2590, Pg.321 - Fnd "T" Iron
 - 5.) 1976-Kobs, P.S. #14097; Survey L.2653, Pg.37 - Fnd "T" Iron, used same wit as 1975 Survey
 - 6.) 1983-Kobs, P.S. #14097; Survey L.3465, Pg.180 - Fnd "T" Iron, used same wit as 1975 Survey
 - 7.) 1987-Kobs, P.S. #14097; Survey L.4220, Pg.474 - Fnd "T" Iron, used wit as 1975 Survey
 - 8.) 1990-Kobs, P.S. #14097; Survey L.4866, Pg.829 - Fnd "T" Iron, used same wit as 1975 Survey
 - 9.) 1990-Kobs, P.S. #14097; Survey L.4866, Pg.830 - Fnd "T" Iron, used same wit as 1975 Survey

B. Description of corner evidence found and/or method applied in restoring or reestablishing corner:

1994 Kennedy Surveying, Inc, - Kennedy, P.S. #17623 - Fnd "T" Iron 2' East of the centerline of Schoenherr Road, which has a gravel Surface to the South, 2' South of the centerline of 29 Mile Road, which has a bituminous surface, and tree row extending to the North.

Witnesses from LCRC #1 & 2 were used to recover and verify the location of the found "T" Iron.

FIELD MEASUREMENT BETWEEN

K-7 to J-7 2725.34 Feet
 K-7 to K-8 2541.70 Feet

ACCEPTED BY THE MACOMB COUNTY SURVEY PEER GROUP AS THE OFFICIAL CORNER UNDER MICHIGAN PUBLIC ACT 345 OF 1990 AT A MEETING HELD ON 8-30-94

 WILLIAM E. SODERBERG, P.S., CHAIRMAN

C. Description of monument for corner and accessories established to perpetuate locating the position of the corner:

K-7 I replaced the "T" Iron with a 3/4" x 24" Iron Rod w/2" diameter aluminum cap stamped "Macomb County Monument HI Act 345 #17623" in a new Monument Box.

N73°E 145.86' Set PK & Remon. Washer South face Power Pole
 S44°E 33.73' Set PK & Remon. Washer SW face 26" Oak
 S46°W 31.48' Set PK & Remon. Washer Top of Guard Rail Post
 N41°W 35.06' Set PK & Remon. Washer Top of Guard Rail Post

The selected location is accepted by me and is generally accepted by Professional Surveyors as the best available evidence of the position of the original corner.

Signed by
 Surveyor's Michigan License No. 17623

Date Aug 21 1994

