

**SURVEY &
REMONUMENTATION**

APR 28 1995

COMMISSION

LAND CORNER RECORDATION CERTIFICATE

Filing Requirement of Act 74, Mich. P.A. 1970

LIBER 06415PC489

For corners in

Washington

Macomb

(County)

Located In: Township Corner Code ##

C105012

- 1. Public Land Survey T 4 N R 12 E K-10
T _____ R _____
T _____ R _____
T _____ R _____
- 2. Property Controlling S _____ T _____ R _____
in Section S _____ T _____ R _____
- 3. Miscellaneous S _____ T _____ R _____
Property in Sec. S _____ T _____ R _____
- 4. Lot No. _____, Recorded Plat _____
- 5. Private Claims _____

94 AUG -5 PM 1:43
CARMELLA S. BAUGH
REGISTER OF DEEDS
MACOMB COUNTY, MI
Register of Deeds Stamp & File Number

I, Huston K. Kennedy, in a field survey on June 15, 19 94, do hereby certify that under requirements of P.A. 74, Michigan P.A. of 1970, the corner points mentioned in lines 1 and 2 above were in conformance with regulations and rules therefore as required in the current manual of survey instructions of the United States Department of the Interior, Bureau of Land Management or by a decree of a Court of Law and/or that the corner points mentioned in lines 3, 4 and 5 above were in conformance with the rules of the Michigan Board of Land Surveyors or by a Decree of a Court of Law; established, re-established, monumented, re-monumented, recovered, found as expressed below:

	A	B	C	D	E	F	G	H	I	J	K	L	M
2	6	5	4	3	2	1							
3													
4	7	8	9	10	11	12							
5													
6	18	17	16	15	14	13							
7													
8	19	20	21	22	23	24							
9													
10	30	29	28	27	26	25							
11													
12	31	32	33	34	35	36							
13													

NOTE: Not more than 4 corners, all in the same town and range, may be recorded on this certificate.

A. Description of original monument and accessories and/or subsequent restoration:

- 1817-GLO Wampler, D.S.; Set Post; 13" Red Oak N65°E 21 Links; 5" Ash N30°W 12 Links
- 1.) 1972-Avey, P.S. #15396; Survey L.2268, Pg.60 - Fnd 1/2" Bar in a Monument Box
- 2.) 1971-Avey, P.S. #15396; Survey L.2252, Pg.235 - Fnd 1/2" Bar in a Monument Box, used same wit as 1972 LCRC

B. Description of corner evidence found and/or method applied in restoring or reestablishing corner:

1994 Kennedy Surveying, Inc. - Kennedy, P.S. #17623 - Fnd two 1/2" Iron Rods side by side in a Monument Box, 3.9' West of the centerline of Schoenherr Road, which has a gravel surface, with a tree-fence row extending to the East, and 87' South of driveway for house #60045.

Witnesses from the Recorded Survey #1 were used to recover and verify the location of the found 1/2" Iron Rods in a Monument Box.

FIELD MEASUREMENT BETWEEN


- K-10 to K-9 2690.74 Feet
- K-10 to K-11 2634.36 Feet

ACCEPTED BY THE MACOMB COUNTY SURVEY PEER GROUP AS THE OFFICIAL CORNER UNDER MICHIGAN PUBLIC ACT 345 OF 1990 AT A MEETING HELD ON 7-19-94.
William E. Soderberg
WILLIAM E. SODERBERG, P.S., CHAIRMAN

C. Description of monument for corner and accessories established to perpetuate locating the position of the corner:

- K-10 I replaced the found 1/2" Iron Rods in a Monument Box with 3/4" x 24" Iron Rod w/2" diameter aluminum cap stamped "Macomb County Monument MI Act 345 #17623" in an existing Monument Box.
- S80°W 23.17' Set PK & Remon. Washer SE face clump 8" Basswood
- S20°E 92.82' Set PK & Remon. Washer SW face Power Pole
- N30°W 37.20' Set PK & Remon. Washer West face 10" Basswood
- N20°W 102.25' Set PK & Remon. Washer East face 28" Oak

The selected location is accepted by me and is generally accepted by Professional Surveyors as the best available evidence of the position of the original corner.

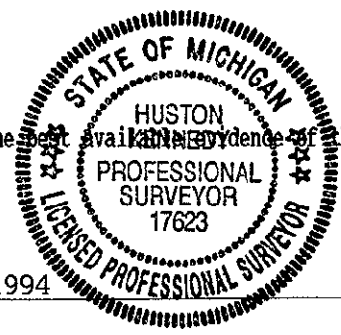

Signed by Huston K. Kennedy
Surveyor's Michigan License No. 17623

Date July 21, 1994