

**SURVEY &
REMONUMENTATION**

**LAND CORNER RECORDATION CERTIFICATE
Filing Requirement of Act 74, Mich. P.A. 1970**

FEB 27 1997

COMMISSION

For corners in

Macomb

(County)

Washington Twp

Located In:

Corner Code #

| | | | |
|------------------------------------|--------------|---------------|-----|
| 1. Public Land Survey | T <u>4</u> N | R <u>12</u> E | L-3 |
| | T | R | |
| | T | R | |
| | T | R | |
| 2. Property Controlling in Section | S | T | R |
| | S | T | R |
| 3. Miscellaneous Property in Sec. | S | T | R |
| | S | T | R |

ACCEPTED BY THE MACOMB COUNTY SURVEY PEER GROUP AS THE OFFICIAL CORNER UNDER MICHIGAN PUBLIC ACT 345 OF 1990 AT A MEETING HELD ON

William E. Soderberg
WILLIAM E. SODERBERG, P.S., CHAIRMAN

Register of Deeds Stamp & File Number

4. Lot No. _____, Recorded Plat _____
5. Private Claims _____

I, Huston K. Kennedy, in a field survey on April 12, 1996 do hereby state that under requirements of P.A. 74, Michigan P.A. of 1970, the corner points mentioned in lines 1 and 2 above were in conformance with regulations and rules therefore as required in the current manual of survey instructions of the United States Department of the Interior, Bureau of Land Management or by a decree of a Court of Law and /or that the corner points mentioned in lines 3, 4 and 5 above were in conformance with the rules of the Michigan Board of Land Surveyors or by a Decree of a Court of Law; established, re-established, monumented, recovered, found as expressed below:

NOTE: Not more than 2 corners, all in the same town and range, may be recorded on this certificate.

| | | | | | | | | | | | | |
|----|----|----|----|----|----|----|---|---|---|---|---|---|
| A | B | C | D | E | F | G | H | I | J | K | L | M |
| 1 | | | | | | | | | | | | |
| 2 | 6 | 5 | 4 | 3 | 2 | 1 | | | | | | |
| 3 | | | | | | | | | | | | |
| 4 | 7 | 8 | 9 | 10 | 11 | 12 | | | | | | |
| 5 | | | | | | | | | | | | |
| 6 | 18 | 17 | 16 | 15 | 14 | 13 | | | | | | |
| 7 | | | | | | | | | | | | |
| 8 | 19 | 20 | 21 | 22 | 23 | 24 | | | | | | |
| 9 | | | | | | | | | | | | |
| 10 | 30 | 29 | 28 | 27 | 26 | 25 | | | | | | |
| 11 | | | | | | | | | | | | |
| 12 | 31 | 32 | 33 | 34 | 35 | 36 | | | | | | |
| 13 | | | | | | | | | | | | |

A. Description of original monument and accessories and/or subsequent restoration:

- 1817-GLO Wampler, D.S.; Set Post 10" Hickory S32°W 14 Links; 8" Beech N22°E 36 Links
- 1.) 1973-Avendt, Jr., PS #16034; LCRC L.2420, Pg.643 - Fnd 3/4" Pipe in a Monument Box
- 2.) 1973-Kobs, PS #14097; LCRC L.2424, Pg.582 - Fnd 1/2" Iron Bar
- 3.) 1977-Kobs, PS #14097; LCRC L.2775, Pg.798 - Fnd 1/2" Iron Bar
- 4.) 1984-Dunn, PS #30081; LCRC L.3695, Pg.536 - Fnd 1/2" Pipe
- 5.) 1980-Kobs, PS #14097; Survey L.3252, Pg.324 - Fnd 1/2" Iron Bar, used same with as 1977 LCRC

B. Description of corner evidence found and/or method applied in restoring or reestablishing corner:

1996 Kennedy Surveying, Inc. - Kennedy, PS #17623 - Fnd 1/2" Iron Rod 5" below the surface in the intersection of 31 Mile Road extending to the East & West with a gravel surface, and Powell Road extending to the Northeast & Southwest, which has a gravel surface.

Witnesses from LCRC #2 & 3 were used to recover and verify the location of the found 1/2" Iron Rod.

Field Measurements see back side of LCRC

C0458176 LIBER:07298 PAGE:202 10:47A 01/02/1997
CARMELLA SABAUGH-MACOMB COUNTY, MI REG/DEEDS


C. Description of monument for corner and accessories established to perpetuate locating the position of the corner:

- L-3 I replaced the found 1/2" Iron Rod with a 3/4" x 24" Iron Rod w/2" diameter aluminum cap stamped "Macomb County Monument MI Act 345" #17623
- S66°W 105.35' Set PK & Remon Washer West face Twin 21" & 24" Maple
- S54°E 49.17' Set PK & Remon Washer NE face 38" Poplar
- N44°W 69.06' Set PK & Remon Washer SW face 12" Cedar
- N58°E 110.07' Set PK & Remon Washer SE face Power Pole

The selected location is accepted by me and is generally accepted by Professional Surveyors as the best available evidence of position of the original corner.

Signed by *[Signature]*
Surveyor's Michigan License No. 17623

Date 12-6-96

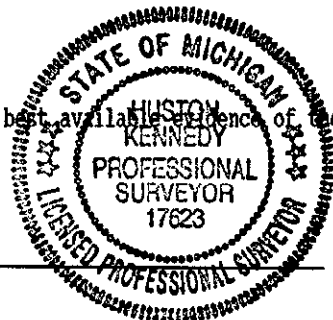

2
9
585

FIELD MEASUREMENTS BETWEEN

L-3 to K-3 GLO = 40.43 chains or 2668.38 Ft.
L-3 to M-3 GLO = 40.43 chains or 2668.38 Ft.
L-3 to H-3 2608.59 Ft. L.3252, Pg.324
L-3 to K-3 2714.59 Ft. (GPS-NEA)
L-3 to M-3 2608.76 Ft. (GPS-NEA)

C0458176 LIBER:07298 PAGE:203 10:47A 01/02/1997
CARMELLA SABAUGH-MACOMB COUNTY, MI REG/DEEDS

SURVEY &
REMONUMENTATION

FEB 27 1997

COMMISSION