

LIBER 05166PG030

B999643

LAND CORNER RECORDATION CERTIFICATE
Filing Requirement of Act 74, Mich. P.A. 1970

For corners in
Macomb
(County)

Located In: Washington Twp.
Corner Code # L-13

RECORDED IN MACOMB COUNTY
RECORDED AT: 8:30 A.M.

DEC 28 1993

Register of Deeds Stamp & File Number

- 1. Public Land Survey T 4 R 12 L-13
2. Property Controlling in Section S T R
3. Miscellaneous Property in Sec. S T R
4. Lot No. , Recorded Plat
5. Private Claims

I, Huston K. Kennedy, in a field survey on December 10, 1993, do hereby certify that under requirements of P.A. 74, Michigan P.A. of 1970, the corner points mentioned in lines 1 and 2 above were in conformance with regulations and rules therefore as required in the current manual of survey instructions of the United States Department of the Interior, Bureau of Land Management or by a decree of a Court of Law and/or that the corner points mentioned in lines 3, 4 and 5 above were in conformance with the rules of the Michigan Board of Land Surveyors or by a Decree of a Court of Law; established, re-established, monumented, re-monumented, recovered, found as expressed below:

Grid table with columns A-L and rows 2-13. Contains numbers 1-36 in a grid pattern.

NOTE: Not more than 4 corners, all in the same town and range, may be recorded on this certificate.

A. Description of original monument and accessories and/or subsequent restoration:
1817-GLO Wampler, D.S.; Set post; 4" Beech S66°W 14 Lnks; 11" Beech N14°W 26 Lnks
1977-Kobs, P.S. #14097; Survey L.2775, Pg.784 - Fnd 5/8" Iron Rod in a monument box.
1977-Kobs, P.S. #14097; Survey L.2882, Pg.428 - Fnd 5/8" Iron Rod in a monument box.
1979-Kobs, P.S. #14097; Survey L.3186, Pg.868 - Fnd 5/8" Iron Rod in a monument box.

B. Description of corner evidence found and/or method applied in restoring or reestablishing corner:
1993 Kennedy Surveying, Inc. - Kennedy, P.S. #17623 - Fnd 3/8" Iron Rod in a monument box 1.5' South of the centerline of 26 Mile Road, which is bituminous surface.


Two witness points from the three Certificates of Surveys listed above were found and they were used to recover and verify the found 3/8" Iron Rod in a monument box.

ACCEPTED BY THE MACOMB COUNTY SURVEY PEER GROUP AS THE OFFICIAL CORNER UNDER MICHIGAN PUBLIC ACT 345 OF 1990 AT A MEETING HELD ON 12-15-93. FRANK J. Dedecker, PE, CHAIRMAN

C. Description of monument for corner and accessories established to perpetuate locating the position of the corner:

L-13 I replaced the found 3/8" Iron Rod in a monument box with a 3/4" x 24" Iron Rod w/2" diameter aluminum cap stamped "Macomb County Monument MI Act 345 #17623" in a monument box.
N75°E-183.61'-Set PK Nail & Remon. tag in South face Power Pole
S85°E-186.50'-Set PK Nail & Remon. tag in North face Power Pole
S03°W-34.12'-Set PK Nail & Remon. tag in East face Power Pole
S78°W-152.09'-Set PK Nail & Remon. tag in North face Power Pole

The selected location is accepted by me and is generally accepted by Professional Surveyors as the best available evidence of the position of the original corner.

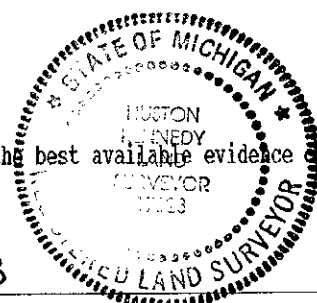

Signed by [Signature]
Surveyor's Michigan License No. 17623

Date 12-10-93