

**LAND CORNER RECORDATION CERTIFICATE**  
Filing Requirement of Act 74, Mich. P.A. 1970

For corners in Washington Twp  
Macomb Located In: Corner Code #  
(County)

1. Public Land Survey	T <u>4N</u> R <u>12E</u>	<u>M-2</u>
	T ___ R ___	_____
	T ___ R ___	_____
	T ___ R ___	_____
2. Property Controlling in Section	S ___ T ___ R ___	_____
	S ___ T ___ R ___	_____
3. Miscellaneous Property in Sec.	S ___ T ___ R ___	_____
	S ___ T ___ R ___	_____

**SURVEY &  
REMONUMENTATION**

FEB 27 1997

COMMISSION

Register of Deeds Stamp & File Number

4. Lot No. \_\_\_\_\_, Recorded Plat \_\_\_\_\_  
5. Private Claims \_\_\_\_\_

	A	B	C	D	E	F	G	H	I	J	K	L	M
1													
2	6	5	4	3	2	1							
3													
4	7	8	9	10	11	12							
5													
6	10	17	16	15	14	13							
7													
8	19	20	21	22	23	24							
9													
10	30	29	28	27	26	25							
11													
12	31	32	33	34	35	36							
13													

Huston K. Kennedy in a field survey on April 12, 1996 do hereby state that under requirements of P.A. 74, Michigan P.A. of 1970, the corner points mentioned in lines 1 and 2 above were in conformance with regulations and rules therefore as required in the current manual of survey instructions of the United States Department of the Interior, Bureau of Land Management or by a decree of a Court of Law and for that the corner points mentioned in lines 3, 4 and 5 above were in conformance with the rules of the Michigan Board of Land Surveyors or by a Decree of a Court of Law, established, re-established, monumented, recovered, found as expressed below:

NOTE: Not more than 2 corners, all in the same town and range, may be recorded on this certificate.

A. Description of original monument and accessories and/or subsequent restoration:

1817-GLO Wampler, D.S.; Set Post; 11" Cherry S10°W 23 Links; 23" Beech N15°W 22 Links  
1.) 1990-Kobs, PS #14097; Survey L.4924, Pg.702 - Fnd 1/2" Re-rod w/cap #30085

ACCEPTED BY THE MACOMB COUNTY SURVEY PEER GROUP AS THE OFFICIAL CORNER UNDER MICHIGAN PUBLIC ACT 345 OF 1990 AT A MEETING HELD ON 4-16-96  
William E. Soderberg  
WILLIAM E. SODERBERG, P.S., CHAIRMAN

B. Description of corner evidence found and/or method applied in restoring or reestablishing corner:

1996 Kennedy Surveying, Inc. - Kennedy, PS #17623 - Fnd 1/2" Iron Rod w/cap #30085 2" below the surface at the base of a 3-way fence corner with a tree, fence & rock row extending North, South & West. The West 1/4 corner of Section 6, T4N, R12E, Ray Twp., (A-2) is located 55.92 feet to the South.

Witnesses from Survey #1 were used to recover and verify the location of the found 1/2" Iron Rod w/cap #30085.

Field Measurements see back side of LCRC

C0458177 LIBER:07298 PAGE:204 10:47A 01/02/1997  
CARMELLA SABAUGH-MACOMB COUNTY, MI REG/DEEDS


C. Description of monument for corner and accessories established to perpetuate locating the position of the corner:

M-2 I replaced the found 1/2" Iron Rod w/cap #30085 with a 3/4" x 24" Iron Rod w/2" diameter aluminum cap stamped "Macomb County Monument MI Act 345" #17623  
Due North 3.38' Set PK & Remon Washer West face 14" Box Elder  
N88°W 27.44' Set PK & Remon Washer South face 8" Ash  
S42°W 9.26' Set PK & Remon Washer SE face 3" Ash  
S07°W 26.46' Set PK & Remon Washer SW face 5" Ash  
South 55.92 feet West 1/4 corner of Section 6, T4N, R12E, Ray Twp., (A-2)

The selected location is accepted by me and is generally accepted by Professional Surveyors as the best position of the original corner.

Signed by [Signature]  
Surveyor's Michigan License No. 17623

Date 12-6-96

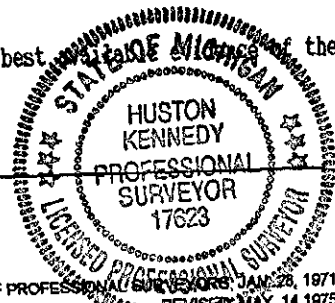

29

586

FIELD MEASUREMENTS BETWEEN

M-2 to A-2 No GLO, 55.92 Ft. (MEA)  
M-2 to M-1 GLO = 48.17 chains or 3179.22 Ft.  
M-2 to M-1 2689.53 Ft. (GPS-MEA)  
M-2 to M-3 GLO = 40 chains or 2640.00 Ft.  
M-2 to M-3 2707.16 Ft. L.4924, Pg.702, 2704.73 Ft. (GPS-MEA)

C0458177 LIBER:07298 PAGE:205 10:47A 01/02/1997  
CARMELLA SABAUGH-MACOMB COUNTY, MI REG/DEEDS

SURVEY &  
REMONUMENTATION

FEB 27 1997

COMMISSION