

LAND CORNER RECORDATION CERTIFICATE
Filing Requirement of Act 74, Mich. P.A. 1970

SURVEY &
 REMONUMENTATION

For corners in

| | | |
|---------------------------------------|--------------------------|---------------|
| <u>Macomb</u> (County) | Located In: Ray Twp | Corner Code # |
| 1. Public Land Survey | T <u>4N</u> R <u>13E</u> | <u>B-13</u> |
| | T _____ R _____ | _____ |
| | T _____ R _____ | _____ |
| | T _____ R _____ | _____ |
| 2. Property Controlling in Section | S _____ T _____ R _____ | _____ |
| | S _____ T _____ R _____ | _____ |
| 3. Miscellaneous Property in Sec. | S _____ T _____ R _____ | _____ |
| | S _____ T _____ R _____ | _____ |

APR 20 2000

SECTION

Register of Deeds Stamp & File Number

4. Lot No. _____, Recorded Plat _____

5. Private Claims _____

| | | | | | | | | | | | | |
|----|----|---|----|---|----|---|----|---|----|---|----|---|
| A | B | C | D | E | F | G | H | I | J | K | L | M |
| 1 | | | | | | | | | | | | |
| 2 | 6 | | 5 | | 4 | | 3 | | 2 | | 1 | |
| 3 | | | | | | | | | | | | |
| 4 | 7 | | 8 | | 9 | | 10 | | 11 | | 12 | |
| 5 | | | | | | | | | | | | |
| 6 | 18 | | 17 | | 16 | | 15 | | 14 | | 13 | |
| 7 | | | | | | | | | | | | |
| 8 | 19 | | 20 | | 21 | | 22 | | 23 | | 24 | |
| 9 | | | | | | | | | | | | |
| 10 | 30 | | 29 | | 28 | | 27 | | 26 | | 25 | |
| 11 | | | | | | | | | | | | |
| 12 | 31 | | 32 | | 33 | | 34 | | 35 | | 36 | |
| 13 | | | | | | | | | | | | |


I, Robert D. Kohn, in a field survey on November 30, 1996 do hereby state that under requirements of P.A. 74, Michigan P.A. of 1970, the corner points mentioned in lines 1 and 2 above were in conformance with regulations and rules therefore as required in the current manual of survey instructions of the United States Department of the Interior, Bureau of Land Management or by a decree of a Court of Law and/or that the corner points mentioned in lines 3, 4 and 5 above were in conformance with the rules of the Michigan Board of Land Surveyors or by a Decree of a Court of Law; established, re-established, monumented, recovered, found as expressed below:

NOTE: Not more than 2 corners, all in the same town and range, may be recorded on this certificate.

C0458204 LIBER:07298 PAGE:237 10:47A 01/02/1997
CARMELLA SABAUGH-MACOMB COUNTY, MI REG/DEEDS

A. Description of original monument and accessories and/or subsequent restoration:

| Year | Description | Name | License # | G.L.O. Notes |
|------|-------------------------------|-------------|-----------|---|
| 1817 | Post | W. Preston | N/A | |
| 1972 | 1/2" Rerod in monument box | C. Melching | #14767 | L.C.R.C. L2285 P457 & Survey L2285 P428 |
| 1980 | 1/2" iron bar in monument box | H. Kobs | #14097 | L.C.R.C. L3287 P577 |
| 1986 | 1/2" iron bar in monument box | H. Kobs | #14097 | Survey L4151 P069 |
| 1991 | 1/2" iron bar in monument box | J. Fenn | #23505 | L.C.R.C. L5042 P547 |
| 1992 | Monument box | G. James | #19835 | Survey L5625 P260 |

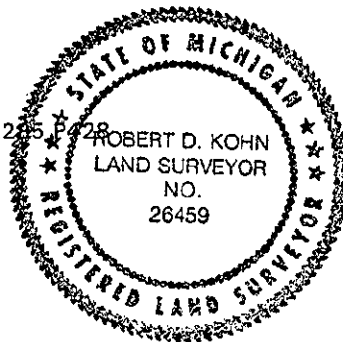

B. Description of corner evidence found and/or method applied in restoring or reestablishing corner:

A capped iron #19835 in an existing monument box in asphalt pavement currently occupies this corner. A wood and wire fence on a tree line extends to the north from this position. The following witness ties were used to verify and recover its position:

- 1 tie matches witnesses from L.C.R.C. L2285 P457 and Survey L2285 P428
- 2 ties match witnesses from L.C.R.C. L3287 P577 and L.C.R.C. L5042 P547, Survey L4151 P069

Field measurements were observed between the following corners:

| | | | | | |
|--------------|-------------------------------|--------------|---------------------|-------------|--------------|
| A-13 to B-13 | 1985.79 meas. | B-13 to C-13 | 2687.05 meas. | B-13 to B-1 | 64.48' meas. |
| | 1947.00 rec. G.L.O. | | 2640.00 rec. G.L.O. | | |
| | 1985.64 rec. Survey L4151 P69 | | | | |

C. Description of monument for corner and accessories established to perpetuate locating the position of the corner:

I replaced the found capped rod with a 3/4" x 24" iron rod with a 2" diameter aluminum cap stamped "Macomb County MI Act 345 #26459" in an existing monument box in asphalt pavement. Witness ties are as follows:

- N. 13°W., 39.40' P.K. nail and Mac Co remon washer in E. face 15" Ash
- N. 47°W., 42.75' P.K. nail and Mac Co remon washer in S.W. face 18" Ash
- Due West 64.48' Mac. Co. remon. cap #26459 in mon box (B-1) Macomb Twp.
- S. 51°E., 67.72' P.K. nail and Mac Co remon washer N.E. face U-pole

ACCEPTED BY THE MACOMB COUNTY SURVEY PEER GROUP AS THE OFFICIAL CORNER UNDER MICHIGAN PUBLIC ACT 345 OF 1990 AT A MEETING HELD ON 7-23-96

 WILLIAM E. SODERBERG, P.S., CHAIRMAN

The selected location is accepted by me and generally accepted by Professional Surveyors as the best available evidence of the position of the original corner.

Signed by Robert D. Kohn
 Surveyor's Michigan License No. #26459

Date November 30, 1996