

LAND CORNER RECORDATION CERTIFICATE
Filing Requirement of Act 74, Mich. P.A. 1970

For corners in

Macomb Located In: Ray Twp. Corner Code #
 (County)

1091832
 LIBER 9268 PAGE 20
 12/27/1999 01:15:42 P.M.
 MACOMB COUNTY, MI
 CARMELLA SABAUGH, REG/DEEDS

1. Public Land Survey T-4-N R-13-E C-12
 T R
 T R SURVEY &
 T R RESTORATION
 2. Property Controlling S T R
 in Section S T R MAR 17 2000
 3. Miscellaneous S T R
 Property in Sec. S T R SECTION

Register of Deeds Stamp & File Number

4. Lot No. _____, Recorded Plat _____

5. Private Claims _____

I, John N. Redash, in a field survey on Jan. 14, 1999 do hereby state that under requirements of P.A. 74, Michigan P.A. of 1970, the corner points mentioned in lines 1 and 2 above were in conformance with regulations and rules therefore as required in the current manual of survey instructions of the United States Department of the Interior, Bureau of Land Management or by a decree of a Court of Law and /or that the corner points mentioned in lines 3, 4 and 5 above were in conformance with the rules of the Michigan Board of Land Surveyors or by a Decree of a Court of Law; established, re-established, monumented, recovered, found as expressed below:

NOTE: Not more than 2 corners, all in the same town and range, may be recorded on this certificate.

	A	B	C	D	E	F	G	H	I	J	K	L	M
1													
2		6		5		4		3		2		1	
3													
4		7		8		9		10		11		12	
5													
6		18		17		16		15		14		13	
7													
8		19		20		21		22		23		24	
9													
10		30		29		28		27		26		25	
11													
12		31		32		33		34		35		36	
13													

A. Description of original monument and accessories and/or subsequent restoration:

1817	Set Post	G.L.O.	W. Preston	N/A	N/A
1980	1/2" iron bar in pavement	Survey	H. Kobs	#14097	L3287, P532
1980	1/2" iron bar in pavement	LCRC	H. Kobs	#14097	L3287, P577
1994	Found iron bar	Survey	G. James	#19835	L6434, P753
1995	1/2" iron bar in pavement	Survey	D. King	#30085	L6595, P670
1998	1/2" iron bar in mon. box	Survey	D. King	#30085	L8045, P007
1998	1/2" iron bar in mon. box	Survey	D. King	#30085	L8045, P16

B. Description of corner evidence found and/or method applied in restoring or reestablishing corner:

A 1/2" iron rod in an existing monument box in asphalt pavement in the centerline of Romeo Plank Rd currently occupies this corner. Evidence of old wire fence exists to the east. 2 ties from L.C.R.C. L3287 P577 were used to recover and verify this corner.

Field measurements were observed between the following corners:

C-11 to C-12	2667.59 meas.	C-12 to C-13	2681.24 meas.
2640.00 Rec. G.L.O.(40 Chains)		2640.00 Rec. G.L.O.(40 Chains)	
2667.89 Rec. Survey L6434 P753		2681.30 Rec. Survey L3287 P532	
2667.49 Rec. Survey L8045 P007		2681.30 Rec. Survey L6595 P670	

C. Description of monument for corner and accessories established to perpetuate locating the position of the corner:

I replaced the 1/2" iron rod in an existing Mon. Box with a 3/4" x 24" iron rod with a 2" diam. aluminum cap stamped "Macomb County Monument MI ACT 345 #37281".


Witnesses are as follows:

Az 08°	144.22'	Set mag nail and Macomb County Remon Tag in west face of utility pole
Az 91°	34.03'	Found nail in old wood fence post
Az 110°	22.34'	Set mag nail and Macomb County Remon Tag in north face of utility pole
Az 173°	172.86'	Set mag nail and Macomb County Remon Tag in west face of utility pole
Az 342°	178.96'	S.E. corner of brick porch to house #58135

The selected location is accepted by me and generally accepted by Professional Surveyors as the best available evidence of the position of the original corner.

Signed by John N. Redash Date 11/22/99

Surveyor's Michigan License No. 37281

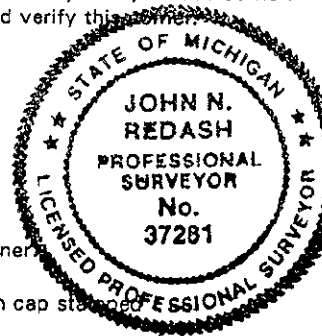

FORM APPROVED BY MICHIGAN STATE BOARD OF PROFESSIONAL SURVEYORS, JAN. 28, 1971
 REVISED MAY 14, 1975
 REVISED JAN., 1983
 REVISED OCT., 1995

ACCEPTED BY THE MACOMB COUNTY SURVEY PEER GROUP AS THE OFFICIAL CORNER UNDER MICHIGAN PUBLIC ACT 345 OF 1990 AT A MEETING HELD ON 9/28/99

William E. Soderberg
 WILLIAM E. SODERBERG, P.S., CHAIRMAN