

**LAND CORNER RECORDATION CERTIFICATE**  
**Filing Requirement of Act 74, Mich. P.A. 1970**

For corners in

<u>Macomb</u> (County)	Located in: <u>Ray Twp</u>	Corner Code # <u>D-13</u>
1. Public Land Survey	<u>T 4N R 13E</u>	<u>_____</u>
	T _____ R _____	<u>_____</u>
	T _____ R _____	<u>_____</u>
	T _____ R _____	<u>_____</u>
2. Property Controlling in Section	S _____ T _____ R _____	<u>_____</u>
	S _____ T _____ R _____	<u>_____</u>
3. Miscellaneous Property in Sec.	S _____ T _____ R _____	<u>_____</u>
	S _____ T _____ R _____	<u>_____</u>

SURVEY &  
 REMONUMENTATION

APR 20 2000

SECTION

Register of Deeds Stamp & File Number

4. Lot No. \_\_\_\_\_, Recorded Plat \_\_\_\_\_

5. Private Claims \_\_\_\_\_

I, Robert D. Kohn, in a field survey on November 30, 19 96 do hereby state that under requirements of P.A. 74, Michigan P.A. of 1970, the corner points mentioned in lines 1 and 2 above were in conformance with regulations and rules therefore as required in the current manual of survey instructions of the United States Department of the Interior, Bureau of Land Management or by a decree of a Court of Law and /or that the corner points mentioned in lines 3, 4 and 5 above were in conformance with the rules of the Michigan Board of Land Surveyors or by a Decree of a Court of Law; established, re-established, monumented, recovered, found as expressed below:


1	A	B	C	D	E	F	G	H	I	J	K	L	M
2		6	5		4		3		2		1		
3													
4		7		8		9		10		11		12	
5													
6		18		17		16		15		14		13	
7													
8		19		20		21		22		23		24	
9													
10		30		29		28		27		26		25	
11													
12		31		32		33		34		35		36	
13													

NOTE: Not more than 2 corners, all in the same town and range, may be recorded on this certificate.

*C0458206 LIBER:07298 PAGE:239 10:47A 01/02/1997*  
*CARMELLA SABAUGH-MACOMB COUNTY, MI REG/DEEDS*

A. Description of original monument and accessories and/or subsequent restoration:

1817	Post	W. Preston	N/A	G.L.O. Notes
1977	Set P.K. nail	J. Barnes	#13616	Survey L2846 P869
1989	Found P.K. nail	H. Kobs	#14097	Survey L4729 P137
1989	Found P.K. nail	H. Kobs	#14097	L.C.R.C. L4729 P129
1991	P.K. nail in pavement	D. King	#30085	Survey L5253 P196

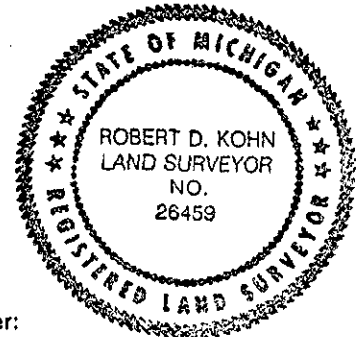

B. Description of corner evidence found and/or method applied in restoring or reestablishing corner:

No physical evidence of actual corner is currently occupying this corner. Corner was re-established using witness ties from L.C.R.C. L4729 P129. All four accessories were used to establish its position.

4 ties were used from witnesses listed on Survey L4729 P137, L.C.R.C. L4729 P129, and Survey L5253 P196

Field measurements were observed between the following corners:

C-13 to D-13	2705.19' meas.	D-13 to E-13	2666.13' meas.	D-13 to D-1	98.28' meas.
	2640.00' rec.G.L.O.		2640.00 rec. G.L.O.		98.28' rec. Survey L5253 P196
			2665.55 rec. Survey L2846 P869		
			2665.90 rec. Survey L4729 P137		

C. Description of monument for corner and accessories established to perpetuate locating the position of the corner:

I placed a 3/4"x 24" iron rod with a 2" diameter aluminum cap stamped "Macomb County Monument MI Act 345 #26459" in a new monument box in asphalt pavement. Witness ties are as follows:

- Due North 33.00' Found 1/2" iron rod
- N60°E. 63.73' P.K. nail and Mac. Co. remon. washer in South face U-pole
- S45°W. 102.00' N.W. corner HSE #17670
- S30°E. 88.86' N.E. corner HSE #17670
- Due West 98.28' Mac. Co. remon. cap & iron #26459 in mon. box (D-1) Mac. Twp.

ACCEPTED BY THE MACOMB COUNTY SURVEY PE  
 GROUP AS THE OFFICIAL CORNER UNDER MICHIG  
 PUBLIC ACT 345 OF 1990 AT A MEETING HE  
 ON 7-53-96  
William E. Soderberg  
 WILLIAM E. SODERBERG, P.S., CHAIRMAN

The selected location is accepted by me and generally accepted by Professional Surveyors as the best available evidence of the position of the original corner.

Signed by Robert D. Kohn  
 Surveyor's Michigan License No. #26459

Date November 30, 1996