

**LAND CORNER RECORDATION CERTIFICATE**  
**Filing Requirement of Act 74, Mich. P.A. 1970**

For corners in

Macomb  
 (County)

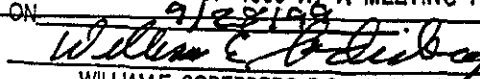
Located In: Ray Twp. Corner Code # \_\_\_\_\_

1091837  
 LIBER 9268 PAGE 25  
 12/27/1999 01:15:42 P.M.  
 MACOMB COUNTY, MI  
 CARMELLA SABAUGH, REG/DEEDS

1. Public Land Survey T-4-N R-13-E  
 T \_\_\_\_\_ R \_\_\_\_\_  
 T \_\_\_\_\_ R \_\_\_\_\_  
 T \_\_\_\_\_ R \_\_\_\_\_
2. Property Controlling S \_\_\_\_\_ T \_\_\_\_\_ R \_\_\_\_\_  
 in Section S \_\_\_\_\_ T \_\_\_\_\_ R \_\_\_\_\_
3. Miscellaneous S \_\_\_\_\_ T \_\_\_\_\_ R \_\_\_\_\_  
 Property in Sec. S \_\_\_\_\_ T \_\_\_\_\_ R \_\_\_\_\_

G-12  
 SURVEY &  
 RESTORATION  
 MAR 17 2000  
 SECTION

Register of Deeds Stamp & File Number

4. Lot No. \_\_\_\_\_, Recorded Plat \_\_\_\_\_
5. Private Claims \_\_\_\_\_
- ACCEPTED BY THE MACOMB COUNTY SURVEY PEER  
 GROUP AS THE OFFICIAL CORNER UNDER MICHIGAN  
 PUBLIC ACT 345 OF 1990 AT A MEETING HELD  
 ON 9/28/99  
  
 WILLIAM E. SODERBERG, P.S., CHAIRMAN

	A	B	C	D	E	F	G	H	I	J	K	L	M
1													
2	6		5		4		3		2		1		
3													
4	7		3		9		10		11		12		
5													
6	18		17		16		15		14		13		
7													
8	19		20		21		22		23		24		
9													
10	30		29		28		27		26		25		
11													
12	31		32		33		34		35		36		
13													

I, John N. Redash, in a field survey on February 5, 1999 do hereby state that under requirements of P.A. 74, Michigan P.A. of 1970, the corner points mentioned in lines 1 and 2 above were in conformance with regulations and rules therefore as required in the current manual of survey instructions of the United States Department of the Interior, Bureau of Land Management or by a decree of a Court of Law and /or that the corner points mentioned in lines 3, 4 and 5 above were in conformance with the rules of the Michigan Board of Land Surveyors or by a Decree of a Court of Law; established, re-established, monumented, recovered, found as expressed below:

**NOTE: Not more than 2 corners, all in the same town and range, may be recorded on this certificate.**

A. Description of original monument and accessories and/or subsequent restoration:

1817	5" dia. ash	G.L.O.	W. Preston	N/A	N/A
1978	1/2" iron bar	Survey	H. Kobs	#14097	L 3021, P 155
1978	1/2" iron bar	LCRC	H. Kobs	#14097	L 3021, P 207
1979	1/2" iron bar	Survey	G. Avendt	#16034	L 3069, P 232
1979	1/2" Iron bar	LCRC	R. Smith	#16052	L 3069, P 228
1990	1/2" iron bar	Survey	D. King	#30085	L 4866, P 823
1990	1/2" iron bar	Survey	D. King	#30085	L 4866, P 834

B. Description of corner evidence found and/or method applied in restoring or reestablishing corner:

A 1/2" iron bar in gravel road (Broughton Road) currently occupies this corner  
 The following witness ties were used to verify its position:  
 Two ties match current measurements from LCRC L 3069, P 228

Field measurements were observed between the following corners:  
 G-11 to G-12 2685.16 meas. G-12 to G-13 2644.60 meas.  
 2640.00 Rec. G.L.O. ((40 Chains) 2640.00 Rec. G.L.O. (40 Chains)  
 2685.24 Rec. Survey L3021 P155 2644.26 Rec. Survey L3069 P 232  
 & L4866 P834 2644.50 Rec. Survey L4866 P 823

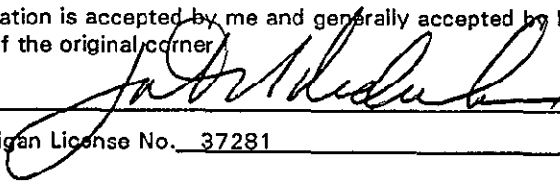


C. Description of monument for corner and accessories established to perpetuate locating the position of the corner:

I replaced the 1/2" iron bar with a 3/4" x 24" iron rod with a 2" diameter aluminum cap stamped "Macomb County Monument MI ACT 345 #37281"

No monument box was set. Witnesses are as follows:  
 S. 22° W. 84.72 feet Set mag nail with Macomb County Remon Tag in east face of 8" Ash.  
 S. 29° W. 67.79 feet Set mag nail with Macomb County Remon Tag in east face of 12" Ash.  
 Due West 30.56 feet Set mag nail with Macomb County Remon Tag in north face of utility pole.  
 S. 82° W. 146.14 feet SE corner of power tower #2604  
 N. 54°W. 145.59 feet SE corner of power tower #7767

The selected location is accepted by me and generally accepted by Professional Surveyors as the best available evidence of the position of the original corner

Signed by  Date 11/22/99  
 Surveyor's Michigan License No. 37281