

LAND CORNER RECORDATION CERTIFICATE
Filing Requirement of Act 74, Mich. P.A. 1970

For corners in

<u>Macomb</u> (County)	Located In: Ray Twp	Corner Code #
1. Public Land Survey	T <u>4N</u> R <u>13E</u>	<u>G-13</u>
	T _____ R _____	_____
	T _____ R _____	_____
	T _____ R _____	_____
2. Property Controlling in Section	S _____ T _____ R _____	_____
	S _____ T _____ R _____	_____
3. Miscellaneous Property in Sec.	S _____ T _____ R _____	_____
	S _____ T _____ R _____	_____

SURVEY &
 REMONUMENTATION

APR 20 2000

SECTION

Register of Deeds Stamp & File Number

4. Lot No. _____, Recorded Plat _____

5. Private Claims _____


I, Robert D. Kohn, in a field survey on November 30, 1996 do hereby state that under requirements of P.A. 74, Michigan P.A. of 1970, the corner points mentioned in lines 1 and 2 above were in conformance with regulations and rules therefore as required in the current manual of survey instructions of the United States Department of the Interior, Bureau of Land Management or by a decree of a Court of Law and /or that the corner points mentioned in lines 3, 4 and 5 above were in conformance with the rules of the Michigan Board of Land Surveyors or by a Decree of a Court of Law; established, re-established, monumented, recovered, found as expressed below:

NOTE: Not more than 2 corners, all in the same town and range, may be recorded on this certificate.

A	B	C	D	E	F	G	H	I	J	K	L	M
1												
2	6	5			4		3		2			1
3												
4	7	8			9		10		11			12
5												
6	18	17			16		15		14			13
7												
8	19	20			21		22		23			24
9												
10	30	29			28		27		26			25
11												
12	31	32			33		34		35			36
13												

A. Description of original monument and accessories and/or subsequent restoration:

1817	Post	W. Preston	N/A	G.L.O. Notes
1979	Old Triangle Iron	R. Smith	#16052	L.C.R.C. L3069 P228
1979	Old Triangle Iron	G. Avendt	#16034	Survey L3169 P36
1980	Found iron	K. Thompson	#16054	Survey L3148 P894
1989	Triangle Iron	D. King	#30085	Survey L4866 P823
1989	1" Triangle Iron	D. King	#30085	L.C.R.C. L4866 P805

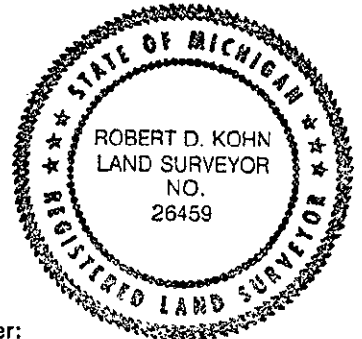

B. Description of corner evidence found and/or method applied in restoring or reestablishing corner:

A 1/2" iron in an existing monument box in asphalt pavement currently occupies this corner. The following witness ties were used to recover and verify its position:

2 ties match L.C.R.C. L4866 P805 and Survey L4866 P823

Field measurements were observed between the following corners:

F-13 to G-13	2670.25' meas.	G-1 to G-13	89.75 meas.
	2640.00' rec. G.L.O.		87.78 rec. G.L.O.
	2669.56 rec. L3069 P232		
	L3148 P894		

ACCEPTED BY THE MACOMB COUNTY SURVEY PEER GROUP AS THE OFFICIAL CORNER UNDER MICHIGAN PUBLIC ACT 345 OF 1990 AT A MEETING HELD ON 11-23-96
William E. Soderberg
 WILLIAM E. SODERBERG, P.S., CHAIRMAN

C. Description of monument for corner and accessories established to perpetuate locating the position of the corner:

I replaced the existing 1/2" iron with a 3/4" x 24" iron rod with a 2" diameter aluminum cap stamped "Macomb County Monument MI Act 345 #26459" in the existing monument box in asphalt pavement. Witness ties are as follows:

N. 32°W.,	59.10'	Nail and tag #30103 in N.W. face U-pole
S. 48°W.,	55.25'	P.K. nail and Mac. Co. remon. washer in north face U-pole
S. 59°E.,	39.38'	Nail and Tag #30103 in E. face 24" Elm
Due West	89.75'	Mac. Co. remon. cap and iron #26459 in mon box (G-1) Mac. Twp.

The selected location is accepted by me and generally accepted by Professional Surveyors as the best available evidence of the position of the original corner.

Signed by Robert D. Kohn
 Surveyor's Michigan License No. #26459

Date November 30, 1996