

MAR 17 2000

LAND CORNER RECORDATION CERTIFICATE
Filing Requirement of Act 74, Mich. P.A. 1970

SECTION

For corners in

Macomb (County)

Located In: Ray Twp. Corner Code #

1091838
LIBER 9268 PAGE 26
12/27/1999 01:15:42 P.M.
MACOMB COUNTY, MI
CARMELLA SABAUGH, REG/DEEDS


Table with 3 columns: Survey Type, Range/Township, and Corner Code. Includes rows for Public Land Survey, Property Controlling, and Miscellaneous Property.

Register of Deeds Stamp & File Number

4. Lot No. , Recorded Plat
5. Private Claims


I, John N. Redash, in a field survey on February 19, 1999 do hereby state that under requirements of P.A. 74, Michigan P.A. of 1970, the corner points mentioned in lines 1 and 2 above were in conformance with regulations and rules therefore as required in the current manual of survey instructions of the United States Department of the Interior, Bureau of Land Management or by a decree of a Court of Law and /or that the corner points mentioned in lines 3, 4 and 5 above were in conformance with the rules of the Michigan Board of Land Surveyors or by a Decree of a Court of Law; established, re-established, monumented, recovered, found as expressed below:

NOTE: Not more than 2 corners, all in the same town and range, may be recorded on this certificate.

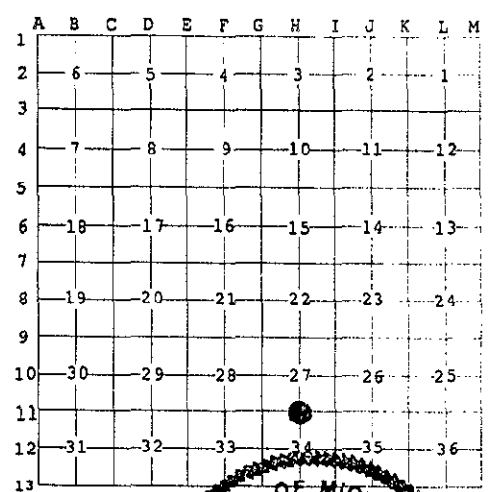

A. Description of original monument and accessories and/or subsequent restoration:

Table with 6 columns: Year, Description, G.L.O., Surveyor, License No., and Reference. Lists monuments from 1817 to 1989.

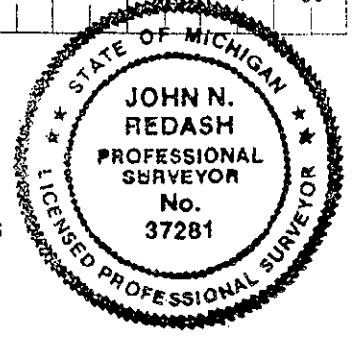

B. Description of corner evidence found and/or method applied in restoring or reestablishing corner:

A 1/2" iron rod inside of a 2" pipe located on a dirt mound along unimproved 27 Mile Road currently occupies this corner. The existing monument is 2.0 feet +/- below grade. The following witness ties were used to verify the position of this corner: Two ties match LCRC in L 4605, P 246.

Field measurements were observed between the following corners:

Table showing field measurements between corners G-11 to H-11, H-11 to I-11, and their respective distances and survey references.

C. Description of monument for corner and accessories established to perpetuate locating the position of the corner:

I set a 3/4" x 24" iron rod with a 2" diameter aluminum cap stamped "Macomb County Monument MI ACT 345, #37281" above existing 1/2" iron inside of a 2" pipe.

Table with 2 columns: Direction and Distance, and Description of Monument. Lists bearings and distances to the north and south, and descriptions of witness monuments.

The selected location is accepted by me and generally accepted by Professional Surveyors as the best available evidence of the position of the original corner.

Signed by [Signature]
Surveyor's Michigan License No. 37281

Date 11/22/99

FORM APPROVED BY MICHIGAN STATE BOARD OF PROFESSIONAL SURVEYORS, JAN. 28, 1971
REVISED MAY 14, 1975
REVISED JAN., 1983
REVISED OCT., 1985

ACCEPTED BY THE MACOMB COUNTY SURVEY PEER GROUP AS THE OFFICIAL CORNER UNDER MICHIGAN PUBLIC ACT 345 OF 1990 AT A MEETING HELD ON 11/28/99
[Signature]
WILLIAM E. SODERBERG, P.S., CHAIRMAN