

**LAND CORNER RECORDATION CERTIFICATE**  
**Filing Requirement of Act 74, Mich. P.A. 1970**

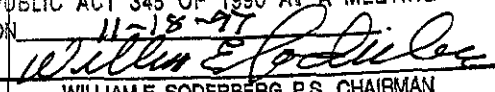
**SURVEY &  
 REMONUMENTATION**

APR 07 1998

For corners in

<u>Macomb</u> (County)	Located In: <u>Ray Twp.</u>	Corner Code #
1. Public Land Survey	<u>T-4-N R-13-E</u>	<u>H-13</u>
	T _____ R _____	_____
	T _____ R _____	_____
	T _____ R _____	_____
2. Property Controlling in Section	S _____ T _____ R _____	_____
	S _____ T _____ R _____	_____
3. Miscellaneous Property in Sec.	S _____ T _____ R _____	_____
	S _____ T _____ R _____	_____

SECTION

ACCEPTED BY THE MACOMB COUNTY SURVEY PEER GROUP AS THE OFFICIAL CORNER UNDER MICHIGAN PUBLIC ACT 345 OF 1990 AT A MEETING HELD ON 11-18-97  
  
 WILLIAM E. SODERBERG, P.S., CHAIRMAN  
 Register of Deeds Stamp & File Number

4. Lot No. \_\_\_\_\_, Recorded Plat \_\_\_\_\_

5. Private Claims \_\_\_\_\_

I, John N. Redash, in a field survey on October 16, 1997 do hereby state that under requirements of P.A. 74, Michigan P.A. of 1970, the corner points mentioned in lines 1 and 2 above were in conformance with regulations and rules therefore as required in the current manual of survey instructions of the United States Department of the Interior, Bureau of Land Management or by a decree of a Court of Law and /or that the corner points mentioned in lines 3, 4 and 5 above were in conformance with the rules of the Michigan Board of Land Surveyors or by a Decree of a Court of Law; established, re-established, monumented, recovered, found as expressed below:

**NOTE: Not more than 2 corners, all in the same town and range, may be recorded on this certificate.**

A	B	C	D	E	F	G	H	I	J	K	L	M
1												
2	6		5		4		3		2		1	
3												
4	7		6		9		10		11		12	
5												
6	18		17		16		15		14		13	
7												
8	19		20		21		22		23		24	
9												
10	30		29		28		27		26		25	
11												
12	31		32		33		34		35		36	
13												

A. Description of original monument and accessories and/or subsequent restoration:

1817	Set post	G.L.O. Notes	W. Preston	N/A	N/A
1979	1/2" Iron bar in pavement	Survey	H. Kobs	#14097	L3188, P879
1989	1/2" Iron with cap #14097	Survey	D. King	#30085	L4866, P823

B. Description of corner evidence found and/or method applied in restoring or reestablishing corner:

A found capped iron (not legible) in asphalt pavement currently occupies this corner. The following witness ties were used to recover and verify its position: 2 ties from survey witnesses L3188, P879 and L4866, P823 match current measurements. A found capped iron #30103 falls due north 32.98'. Field observations were obtained between the following corners:

G-13 to H-13	H-13 to I-13	H-1 to H-13
2687.88 meas.	2703.40 meas.	87.22 meas.
2640.00 Rec. G.L.O.	2640.00 Rec. G.L.O.	No. G.L.O. available
2688.04 Rec. Survey L4866, P823		87.52' Rec. Survey L3188, P879

C. Description of monument for corner and accessories established to perpetuate locating the position of the corner:

I replaced the found capped iron with a 3/4" X 24" iron rod with a 2" aluminum disk stamped "Macomb County Monument MI Act 345 #37281" in asphalt pavement in a new monument box. Witnesses are as follows:

- N. 38° E. 35.19' Set P.K. nail and Macomb County Remon. washer N.W. face 8" Ash
- S. 30° E. 45.02' Set P.K. nail and Macomb County Remon. washer N.E. face U-pole
- S. 60° W. 51.61' Set P.K. nail and Macomb County Remon. washer N.W. face 56" Oak
- N. 10° W. 32.86' Set P.K. nail and Macomb County Remon. washer S.W. face 8" Ash
- Due North 32.98' Found capped iron #30103
- Due West 87.22' Mac. Co. Remon Cap #37281 in monument box (H-1) T-3-N., R-13-E.



The selected location is accepted by me and generally accepted by Professional Surveyors as the best available evidence of the position of the original corner.

Signed by John N. Redash Date December 16, 1997

Surveyor's Michigan License No. 37281