

MAR 17 2000

LAND CORNER RECORDATION CERTIFICATE
Filing Requirement of Act 74, Mich. P.A. 1970

SECTION

For corners in

Macomb (County)

Located In: Ray Twp. Corner Code #

1091839
LIBER 9268 PAGE 27
12/27/1999 01:15:42 P.M.
MACOMB COUNTY, MI
CARHELLA SABAUGH, REG/DEEDS

Table with 3 columns: Description, T, R, and a blank column. Rows include Public Land Survey, Property Controlling in Section, and Miscellaneous Property in Sec.

Register of Deeds Stamp & File Number


4. Lot No. , Recorded Plat

5. Private Claims

I, John N. Redash, in a field survey on February 5, 1999 do hereby state that under requirements of P.A. 74, Michigan P.A. of 1970, the corner points mentioned in lines 1 and 2 above were in conformance with regulations and rules therefore as required in the current manual of survey instructions of the United States Department of the Interior, Bureau of Land Management or by a decree of a Court of Law and/or that the corner points mentioned in lines 3, 4 and 5 above were in conformance with the rules of the Michigan Board of Land Surveyors or by a Decree of a Court of Law; established, re-established, monumented, recovered, found as expressed below:

NOTE: Not more than 2 corners, all in the same town and range, may be recorded on this certificate.

Grid table with columns A-L and rows 1-13. Contains numerical data points.

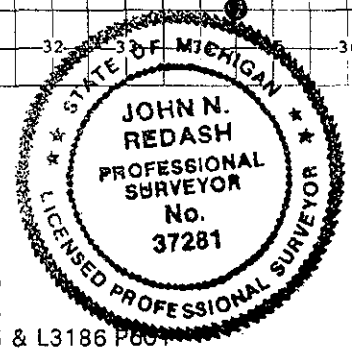

A. Description of original monument and accessories and/or subsequent restoration:

Table with 6 columns: Year, Description, G.L.O., Name, ID#, and Reference. Lists various monuments like Set post, iron pipe, iron bar, and iron bar.

B. Description of corner evidence found and/or method applied in restoring or reestablishing corner:

A boat spike in the intersection of 27 Mile Road (gravel) and Ray Center Road (gravel) currently occupies this corner. The following witnesses were used to verify its position: Two ties match current measurements from LCRC, L 4605, P 246

Field measurements were observed between the following corners:
H-11 to I-11 2686.76 meas. I-11 to I-12 2686.62 meas. I-11 to J-11 2688.06 meas.
2648.25 Rec. G.L.O. (40.13Chains) 2640.00 Rec. G.L.O. (40 Chains) 2640.00 Rec. G.L.O. (40 Chains)
2686.32 Rec. Survey L 2394, P 279 2667.78 Rec. L 3062, P 538

C. Description of monument for corner and accessories established to perpetuate locating the position of the corner:

I replaced the boat spike in the gravel road with a 3/4" x 24" iron rod with a 2" diameter aluminum cap stamped "Macomb County Monument MI ACT 345 #37281".

Witnesses are as follows:

Table with 4 columns: Bearing, Distance, and Description of witness monument (e.g., Set mag nail with Macomb County Remon Tag).

The selected location is accepted by me and generally accepted by Professional Surveyors as the best available evidence of the position of the original corner.

Signed by [Signature] Date 11/22/99
Surveyor's Michigan License No. 37821

ACCEPTED BY THE MACOMB COUNTY SURVEY PEER GROUP AS THE OFFICIAL CORNER UNDER MICHIGAN PUBLIC ACT 345 OF 1990 AT A MEETING HELD ON 9/28/99
WILLIAM E. SODERBERG, P.S., CHAIRMAN

967