

MAR 17 2000

LAND CORNER RECORDATION CERTIFICATE
Filing Requirement of Act 74, Mich. P.A. 1970

SECTION

For corners in

Macomb (County)

Located In: Ray Twp. Corner Code #

1091840
LIBER 9268 PAGE 28
12/27/1999 01:15:42 P.M.
MACOMB COUNTY, MI
CARMELLA SABAUGH, REG/DEEDS

- 1. Public Land Survey T -4-N R -13-E I-12
2. Property Controlling in Section S T R
3. Miscellaneous Property in Sec. S T R


Register of Deeds Stamp & File Number

4. Lot No. , Recorded Plat

5. Private Claims

I, John N. Redash, in a field survey on February 5, 1999 do hereby state that under requirements of P.A. 74, Michigan P.A. of 1970, the corner points mentioned in lines 1 and 2 above were in conformance with regulations and rules therefore as required in the current manual of survey instructions of the United States Department of the Interior, Bureau of Land Management or by a decree of a Court of Law and/or that the corner points mentioned in lines 3, 4 and 5 above were in conformance with the rules of the Michigan Board of Land Surveyors or by a Decree of a Court of Law; established, re-established, monumented, recovered, found as expressed below.

NOTE: Not more than 2 corners, all in the same town and range, may be recorded on this certificate.

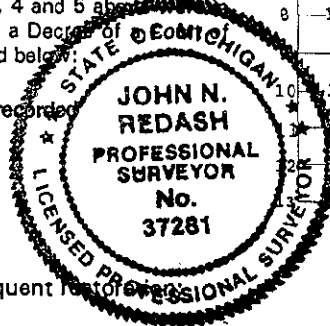

Grid table with columns A-L and rows 1-36. A dot is marked at row 10, column J.

Table A: Description of original monument and accessories and/or subsequent restoration. Columns include Year, Description, G.L.O., Surveyor, and Reference.

B. Description of corner evidence found and/or method applied in restoring or reestablishing corner: A 1/2" Iron rod located 2.5 feet ± south of an east/west fence line, and 150 feet ± west of centerline of Ray Center Road currently occupies this corner.

The following witness ties were used to verify its position: One tie matches current measurements from LCRC L 3074, P 502; while two ties match LCRC's L 3168, P 261, and L 4605, P 245

Field measurements were observed between the following corners: I-11 to I-12 2686.62' meas. I-12 to I-13 2684.49' meas. 2640.00 Rec. G.L.O. (40 Chains) 2640.00 Rec. G.L.O. (40 Chains)

C. Description of monument for corner and accessories established to perpetuate locating the position of the corner: I replaced the 1/2" iron rod with a 3/4" x 24" iron rod with a 2" diameter aluminum cap stamped "Macomb County Monument MI ACT 345, #37281".

- Witnesses are as follows: N. 40° E 2.50 feet Set mag nail and Macomb County Remon Tag in south face of 6" x 8" fence post. East 5.17 feet Found 1 1/2" pipe. S 15° E 81.56 feet Set mag nail and Macomb County Remon Tag in east face of 15" scotch pine. West 19.67 feet Set mag nail and Macomb County Remon Tag in south face of utility pole. S 50° W 132.18 feet Set mag nail and Macomb County Remon Tag in southeast face of 15" elm.

The selected location is accepted by me and generally accepted by Professional Surveyors as the best available evidence of the position of the original corner.

Signed by [Signature] Surveyor's Michigan License No. 37281

Date 11/22/99

ACCEPTED BY THE MACOMB COUNTY SURVEY PEER GROUP AS THE OFFICIAL CORNER UNDER MICHIGAN PUBLIC ACT 345 OF 1990 AT A MEETING HELD ON 9/28/99

WILLIAM E. SODERBERG, P.S., CHAIRMAN

918