

MAR 17 2000

LAND CORNER RECORDATION CERTIFICATE
Filing Requirement of Act 74, Mich. P.A. 1970

SECTION


For corners in

Macomb (County)

Located In: Ray Twp. Corner Code #

1091841
LIBER 9268 PAGE 29
12/27/1999 01:15:42 P.M.
MACOMB COUNTY, MI
CARRELLA SABAUGH, REG/DEEDS

- 1. Public Land Survey T -4-N R -13-E J-11
2. Property Controlling in Section S T R
3. Miscellaneous Property in Sec. S T R

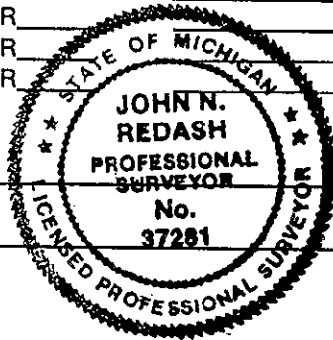

Register of Deeds Stamp & File Number

- 4. Lot No. , Recorded Plat
5. Private Claims

Grid table with columns A-L and rows 1-13. A dot is present at row 11, column K.

I, John N. Redash, in a field survey on February 5, 1999 do hereby state that under requirements of P.A. 74, Michigan P.A. of 1970, the corner points mentioned in lines 1 and 2 above were in conformance with regulations and rules therefore as required in the current manual of survey instructions of the United States Department of the Interior, Bureau of Land Management or by a decree of a Court of Law and /or that the corner points mentioned in lines 3, 4 and 5 above were in conformance with the rules of the Michigan Board of Land Surveyors or by a Decree of a Court of Law; established, re-established, monumented, recovered, found as expressed below:

NOTE: Not more than 2 corners, all in the same town and range, may be recorded on this certificate.

A. Description of original monument and accessories and/or subsequent restoration:

Table with columns for date, monument type, G.L.O., name, license number, and reference numbers.

B. Description of corner evidence found and/or method applied in restoring or reestablishing corner:

A 1/2" iron rod in an unimproved area of 27 Mile Road (gravel) currently occupies this corner. The following witness ties were used to verify its position: 3 ties match current measurements from L 3062, P 515

Field measurements were observed between the following corners:

Table showing measurements between corners I-11 to J-11 and J-11 to K-11.

C. Description of monument for corner and accessories established to perpetuate locating the position of the corner:

I replaced the 1/2" iron rod in gravel road with a 3/4" x 24" iron rod with a 2" diameter aluminum cap stamped "Macomb County Monument MI ACT 345 37281".

Witnesses are as follows:

Table listing witness bearings and distances, and the monument set for each.

The selected location is accepted by me and generally accepted by Professional Surveyors as the best available evidence of the position of the original corner.

Signed by [Signature]
Surveyor's Michigan License No. 37281

Date 11/22/99

NOTED BY THE MACOMB COUNTY SURVEY PEER BOARD AS THE OFFICIAL CORNER UNDER MICHIGAN PUBLIC ACT 345 OF 1990 AT A MEETING HELD ON 9/28/99
WILLIAM E. SODERBERG, P.S., CHAIRMAN

907