

SURVEY & REMONUMENTATION

LAND CORNER RECORDATION CERTIFICATE
Filing Requirement of Act 74, Mich. P.A. 1970

APR 07 1998

For corners in

Macomb Located In: Ray Twp. Corner Code # _____
 (County)

1. Public Land Survey T-4-N R-13-E J-13
 T _____ R _____
 T _____ R _____
 T _____ R _____

2. Property Controlling S _____ T _____ R _____
 in Section S _____ T _____ R _____
 3. Miscellaneous S _____ T _____ R _____
 Property in Sec. S _____ T _____ R _____

SECTION

Register of Deeds Stamp & File Number

4. Lot No. _____, Recorded Plat _____

5. Private Claims _____

I, John N. Redash, in a field survey on October 16, 1997 do hereby state that under requirements of P.A. 74, Michigan P.A. of 1970, the corner points mentioned in lines 1 and 2 above were in conformance with regulations and rules therefore as required in the current manual of survey instructions of the United States Department of the Interior, Bureau of Land Management or by a decree of a Court of Law and /or that the corner points mentioned in lines 3, 4 and 5 above were in conformance with the rules of the Michigan Board of Land Surveyors or by a Decree of a Court of Law; established, re-established, monumented, recovered, found as expressed below:

NOTE: Not more than 2 corners, all in the same town and range, may be recorded on this certificate.

A	B	C	D	E	F	G	H	I	J	K	L	M
1												
2	6		5		4		3		2		1	
3												
4	7		8		9		10		11		12	
5												
6	18		17		16		15		14		13	
7												
8	19		20		21		22		23		24	
9												
10	30		29		28		27		26		25	
11												
12	31		32		33		34		35		36	
13												

A. Description of original monument and accessories and/or subsequent restoration:

1817	set post	G.L.O. Notes	W. Preston	N/AN/A	
1978	P.K. nail in pavement	Survey	G. James	#19835	L3010, P270
1978	P.K. nail in pavement	Survey	G. James	#19835	L3010, P271

B. Description of corner evidence found and/or method applied in restoring or reestablishing corner:


A found P.K. nail 0.20' below the surface 1.2' north of centerline currently occupies this corner. The following witness ties were used to recover and verify its position: No witnesses remain from survey witnesses L3010, P270, 271. Field observations were obtained between the following corners:

I-13 to J-13	J-13 to K-13	J-13 to J-1
2678.76 meas.	2676.68 meas.	58.71 meas.
2640.00 Rec. G.L.O.	2640.00 Rec. G.L.O.	No. G.L.O. available
2679.11 Rec. Survey, L3010, P271		

C. Description of monument for corner and accessories established to perpetuate locating the position of the corner:

I replaced the found P.K. nail with a 3/4" X 24" iron rod with a 2" diameter aluminum disk stamped "Macomb County Monument MI Act 345 #37281" and a new monument box in asphalt pavement. Witnesses are as follows:

- N. 72° E., 71.41' Set P.K. Nail and Macomb County Remon. washer S.E. face 6" Elm
- S. 17° E., 97.01' Set P.K. Nail and Macomb County Remon. washer W. face U-pole
- S. 69° W., 70.68' Set P.K. nail and Macomb County Remon. S.E. face 12" Elm
- West 58.71' Macomb County Remon. disk in monument box (J-1, T-3-N., R-13-E.)
- N. 08° E., 65.28' Set P.K. nail and Macomb County Remon. washer W. face U-pole

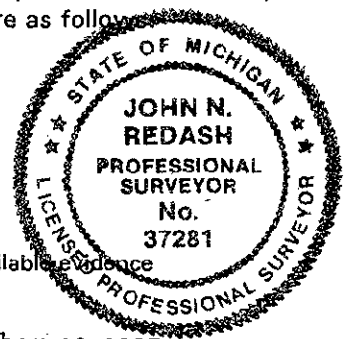

The selected location is accepted by me and generally accepted by Professional Surveyors as the best available evidence of the position of the original corner.

Signed by John N. Redash
 Surveyor's Michigan License No. 37281

Date December-16, 1997

FORM APPROVED BY MICHIGAN STATE BOARD OF PROFESSIONAL SURVEYORS, JAN. 28, 1971
 REVISED MAY 14, 1976
 REVISED JAN., 1983
 REVISED OCT., 1996

ACCEPTED BY THE MACOMB COUNTY SURVEY PEER GROUP AS THE OFFICIAL CORNER UNDER MICHIGAN PUBLIC ACT 345 OF 1990 AT A MEETING HELD ON 11-17-97
William E. Soderberg
 WILLIAM E. SODERBERG, P.S., CHAIRMAN

702