


**LAND CORNER RECORDATION CERTIFICATE**  
**Filing Requirement of Act 74, Mich. P.A. 1970**

For corners in

Macomb Located In: Ray Twp. Corner Code #  
 (County)

1. Public Land Survey T-4-N R-13-E K-11  
 T R  
 T R  
 T R
2. Property Controlling in Section S T R  
 S T R
3. Miscellaneous Property in Sec. S T R  
 S T R

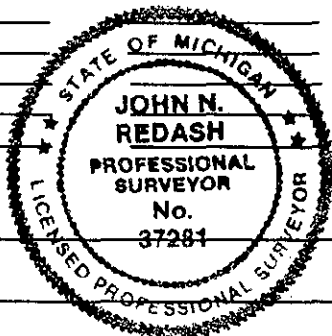

4. Lot No. \_\_\_\_\_, Recorded Plat \_\_\_\_\_
5. Private Claims \_\_\_\_\_

SURVEY &  
 REMONUMENTATION

MAR 15 1999

SECTION

Register of Deeds Stamp & File Number

I, John N. Redash, in a field survey on Jan. 6, 1998 do hereby state that under requirements of P.A. 74, Michigan P.A. of 1970, the corner points mentioned in lines 1 and 2 above were in conformance with regulations and rules therefore as required in the current manual of survey instructions of the United States Department of the Interior, Bureau of Land Management or by a decree of a Court of Law and for that the corner points mentioned in lines 3, 4 and 5 above were in conformance with the rules of the Michigan Board of Land Surveyors or by a Decree of a Court of Law; established, re-established, monumented, recovered, found as expressed below:

NOTE: Not more than 2 corners, all in the same town and range, may be recorded on this certificate.

1	A	B	C	D	E	F	G	H	I	J	K	L	M
2		6		5		4		3		2		1	
3													
4		7		8		9		10		11		12	
5													
6		18		17		16		15		14		13	
7													
8		19		20		21		22		23		24	
9													
10		30		29		28		27		26		25	
11													
12		31		32		33		34		35		36	
13													

A. Description of original monument and accessories and/or subsequent restoration:

Date	Description	G.L.O. Notes	W. Preston	N/A	N/A
1817	18" Dia. Maple				
1946	"C.H. Jobse Little Farms"	Plat	K. Brink	N/A	L24, P1
1978	1/2" iron bar with cap #16054	Survey	H. Kobs	#14097	L3062, P537
1978	Found 1/2" iron	Survey	R. Smith	#16052	L3023, P365
1978	Found 1/2" iron	L.C.R.C.	R. Smith	#16052	L3023, P366
1979	Found 1/2" rod with cap #16054	L.C.R.C.	H. Kobs	#14097	L3062, P514
1980	Found 1/2" rod	Survey	R. Smith	#16052	L3204, P460

B. Description of corner evidence found and/or method applied in restoring or reestablishing corner:

A found 1/2" iron rod with Cap #30085 in centerline of 27 Mile Road (gravel) currently occupies this corner. The following witness ties were used to recover and verify its position: One tie matched current measurements from L.C.R.C.s L3023, P366. Field measurements were observed between the following corners:

K-11 to K-12	Meas.	K-11 to L-11	Meas.
2685.06		2700.63	
2640.00	G.L.O.	2659.14	G.L.O.
2685.25	Rec. Plat L24, P1	2700.43	Rec. Survey L3062, P537

ACCEPTED BY THE MACOMB COUNTY SURVEY PEER GROUP AS THE OFFICIAL CORNER UNDER MICHIGAN PUBLIC ACT 345 OF 1990 AT A MEETING HELD ON 10/17/98  
William E. Soderberg  
 WILLIAM E. SODERBERG, P.S., CHAIRMAN

C. Description of monument for corner and accessories established to perpetuate locating the position of the corner:

I replaced the found 1/2" iron rod with a 3/4" X 24" iron rod with a 2" diameter aluminum cap stamped "Macomb County Monument MI Act 345 #37281" in a gravel road. Witness ties are as follows:

AZ. 05°	60.40'	Set mag nail and Macomb County Remon. tag in W. face wood fence post
AZ. 69°	57.31'	Set mag nail and Macomb County Remon. tag in S. face 6" Elm
AZ. 186°	33.03'	Found square concrete monument
AZ. 261°	127.28'	Set mag nail and Macomb County Remon. tag in S. face utility pole
AZ. 298°	133.29'	Set mag nail and Macomb County Remon. tag in S. face utility pole

The selected location is accepted by me and generally accepted by Professional Surveyors as the best available evidence of the position of the original corner.

Signed by [Signature] Date 12-23-98  
 Surveyor's Michigan License No. 37281

FORM APPROVED BY MICHIGAN STATE BOARD OF PROFESSIONAL SURVEYORS, JAN. 28, 1971  
 REVISED MAY 14, 1975  
 REVISED JAN., 1983  
 REVISED OCT., 1995