

**LAND CORNER RECORDATION CERTIFICATE**  
**Filing Requirement of Act 74, Mich. P.A. 1970**

For corners in

Macomb Located In: Ray Twp. Corner Code # \_\_\_\_\_  
 (County)


1. Public Land Survey T-4-N R-13-E K-12  
 T \_\_\_\_\_ R \_\_\_\_\_  
 T \_\_\_\_\_ R \_\_\_\_\_  
 T \_\_\_\_\_ R \_\_\_\_\_

2. Property Controlling in Section S \_\_\_\_\_ T \_\_\_\_\_ R \_\_\_\_\_  
 S \_\_\_\_\_ T \_\_\_\_\_ R \_\_\_\_\_

3. Miscellaneous Property in Sec. S \_\_\_\_\_ T \_\_\_\_\_ R \_\_\_\_\_  
 S \_\_\_\_\_ T \_\_\_\_\_ R \_\_\_\_\_

4. Lot No. \_\_\_\_\_, Recorded Plat \_\_\_\_\_

5. Private Claims \_\_\_\_\_

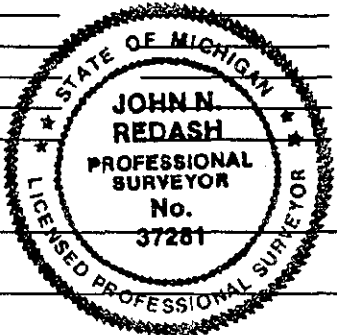

SURVEY &  
 REMONUMENTATION

MAR 15 1999

SECTION

Register of Deeds Stamp & File Number

1	A	B	C	D	E	F	G	H	I	J	K	L	M
2		6		5		4		3		2		1	
3													
4		7		8		9		10		11		12	
5													
6		18		17		16		15		14		13	
7													
8		19		20		21		22		23		24	
9													
10		30		29		28		27		26		25	
11													
12		31		32		33		34		35		36	
13													

I, John N. Redash, in a field survey on Jan. 6, 1998 do hereby state that under requirements of P.A. 74, Michigan P.A. of 1970, the corner points mentioned in lines 1 and 2 above were in conformance with regulations and rules therefore as required in the current manual of survey instructions of the United States Department of the Interior, Bureau of Land Management or by a decree of a Court of Law and /or that the corner points mentioned in lines 3, 4 and 5 above were in conformance with the rules of the Michigan Board of Land Surveyors or by a Decree of a Court of Law; established, re-established, monumented, recovered, found as expressed below:

NOTE: Not more than 2 corners, all in the same town and range, may be recorded on this certificate.

A. Description of original monument and accessories and/or subsequent restoration:

1817	Set post	G.L.O. Notes	W. Preston	N/A	N/A
1946	"C.H. Jobse Little Farms"	Plat	K. Brink	N/A	L24, P1
1973	1" Pipe in center of creek	Survey	H. Kobs	#14097	L2466, P719
1974	1" Pipe in center of creek	L.C.R.C.	H. Kobs	#14097	L2466, P730

B. Description of corner evidence found and/or method applied in restoring or reestablishing corner:

A 1" pipe in approximate centerline of Coon Creek 0.6' below water elevation currently occupies this corner. The following witness ties were used to recover and verify its position: Two ties match current measurements from L.C.R.C. L2466, P730. Field measurements were observed between the following corners:

K-12 to K-13	2668.04 Meas.	K-12 to K-11	2685.06 Meas.
2640.00 G.L.O.		2640.00 G.L.O.	
		2685.25 Rec. Plat L24, P1	

ACCEPTED BY THE MACOMB COUNTY SURVEY PEER GROUP AS THE OFFICIAL CORNER UNDER MICHIGAN PUBLIC ACT 345 OF 1990 AT A MEETING HELD ON 10/13/98  
  
 WILLIAM E. SODERBERG, P.S., CHAIRMAN

C. Description of monument for corner and accessories established to perpetuate locating the position of the corner:

I set a 1/2" X 6' iron rod with a 2" diameter aluminum cap stamped "Macomb County Monument MI Act 345 #37281" inside of the found 1" pipe. The 1/2" iron and aluminum cap is approximately 1' above the water elevation. Witness ties are as follows:

AZ. 56°	139.60'	Cut notch S.W. corner of Power Tower #7754
AZ. 102°	52.34'	Found concrete monument
AZ. 212°	12.94'	Cut notch in E. corner of Power Tower #2591
AZ. 245°	26.62'	Cut notch in N.W. corner of Power Tower #2591

The selected location is accepted by me and generally accepted by Professional Surveyors as the best available evidence of the position of the original corner.

Signed by John N. Redash Date 12-23-98  
 Surveyor's Michigan License No. 37281