

LAND CORNER RECORDATION CERTIFICATE
Filing Requirement of Act 74, Mich. P.A. 1970

For corners in

Macomb Located In: Ray Twp. Corner Code # _____
 (County)

1. Public Land Survey T-4-N R-13-E L-11
 T _____ R _____
 T _____ R _____
 T _____ R _____
 T _____ R _____

2. Property Controlling in Section S _____ T _____ R _____
S _____ T _____ R _____

3. Miscellaneous Property in Sec. S _____ T _____ R _____
S _____ T _____ R _____

SURVEY &
 REMONUMENTATION


MAR 15 1999

SECTION

Register of Deeds Stamp & File Number

4. Lot No. _____, Recorded Plat _____

5. Private Claims _____

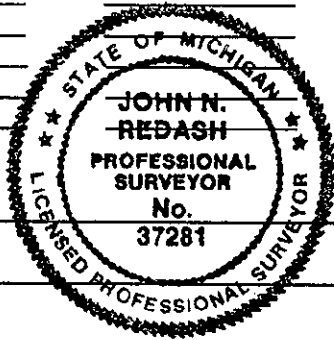

	A	B	C	D	E	F	G	H	I	J	K	L	M
1													
2	6		5		4		3		2		1		
3													
4	7		8		9		10		11		12		
5													
6	18		17		16		15		14		13		
7													
8	19		20		21		22		23		24		
9													
10	30		29		28		27		26		25		
11													
12	31		32		33		34		35		36		
13													

I, John N. Redash, in a field survey on Jan. 6, 1998 do hereby state that under requirements of P.A. 74, Michigan P.A. of 1970, the corner points mentioned in lines 1 and 2 above were in conformance with regulations and rules therefore as required in the current manual of survey instructions of the United States Department of the Interior, Bureau of Land Management or by a decree of a Court of Law and /or that the corner points mentioned in lines 3, 4 and 5 above were in conformance with the rules of the Michigan Board of Land Surveyors or by a Decree of a Court of Law; established, re-established, monumented, recovered, found as expressed below:

NOTE: Not more than 2 corners, all in the same town and range, may be recorded on this certificate.

A. Description of original monument and accessories and/or subsequent restoration:

1817	Set post	G.L.O. Notes	W. Preston	N/A	N/A
1978	1/2" iron bar	Survey	H. Kobs	#14097	L3036, P16
1979	1/2" iron bar	L.C.R.C.	H. Kobs	#14097	L3062, P514

B. Description of corner evidence found and/or method applied in restoring or reestablishing corner:

A 1/2" iron rod in approximate centerline of an existing two track lane currently occupies this corner. The following witness ties were used to recover and verify its position: Three ties match current measurements from L.C.R.C. L3062, P514. Field measurements were observed between the following corners:

K-11 to L-11		
2700.63	Meas.	
2659.14	Rec.	G.L.O.
2700.43	Rec.	Survey L3062, P016

ACCEPTED BY THE MACOMB COUNTY SURVEY PEER GROUP AS THE OFFICIAL CORNER UNDER MICHIGAN PUBLIC ACT 345 OF 1990 AT A MEETING HELD ON 10/10/98.

 WILLIAM E. SODERBERG, P.S., CHAIRMAN

C. Description of monument for corner and accessories established to perpetuate locating the position of the corner:

I replaced the found 1/2" iron with a 4" x 36" concrete monument with a 2" aluminum cap stamped "Macomb County Monument MI Act 345 #37281" in an existing two track lane. Witnesses are as follows:

AZ.	52°	31.20'	Set mag nail and Macomb County Remon. tag in S.E. face Twin 6" Oak
AZ.	178°	30.10'	Set mag nail and Macomb County Remon. tag in W. face Twin 10" Oak
AZ.	255°	62.00'	Set mag nail and Macomb County Remon. tag in N. face 20" Poplar
AZ.	346°	39.23'	Set mag nail and Macomb County Remon. tag in E. face 40" Oak

The selected location is accepted by me and generally accepted by Professional Surveyors as the best available evidence of the position of the original corner.

Signed by Date 12-23-98

Surveyor's Michigan License No. 37281

FORM APPROVED BY MICHIGAN STATE BOARD OF PROFESSIONAL SURVEYORS, JAN. 28, 1971
 REVISED MAY 14, 1975
 REVISED JAN., 1983
 REVISED OCT., 1995

C0865227 LIBER:08571 PAGE:775 09:29A 01/21/1999
 CARMELLA SABAUGH-MACOMB COUNTY, MI REG/DEEDS

833