

LAND CORNER RECORDATION CERTIFICATE
Filing Requirement of Act 74, Mich. P.A. 1970

For corners in

<u>Macomb</u> (County)	Located In:	Corner Code #
	Ray Township	
1. Public Land Survey	T 4N R 13E	M4
	T _____ R _____	_____
	T _____ R _____	_____
	T _____ R _____	_____
2. Property Controlling in Section	S _____ T _____ R _____	_____
	S _____ T _____ R _____	_____
3. Miscellaneous Property in Sec.	S _____ T _____ R _____	_____
	S _____ T _____ R _____	_____

SURVEY &
 REMONUMENTATION

FEB 27 1997

COMMISSION

Register of Deeds Stamp & File Number

4. Lot No. _____, Recorded Plat _____
 5. Private Claims _____

1	A	B	C	D	E	F	G	H	I	J	K	L	M
2		6	5	4	3	2	1						
3													
4		7	8	9	10	11	12						
5													
6		18	17	16	15	14	13						
7													
8		19	20	21	22	23	24						
9													
10		30	29	28	27	26	25						
11													
12		31	32	33	34	35	36						
13													

I, Craig P. Amey, in a field survey on June 15, 1996 do hereby certify that under requirements of P.A. 74, Michigan P.A. of 1970, the corner points mentioned in lines 1 and 2 above were in conformance with regulations and rules therefore as required in the current manual of survey instructions of the United States Department of the Interior, Bureau of Land Management or by a decree of a Court of Law and /or that the corner points mentioned in lines 3, 4 and 5 above were in conformance with the rules of the Michigan Board of Land Surveyors or by a Decree of a Court of Law; established, re-established, monumented, re-monumented, recovered, found as expressed below:

NOTE: Not more than 4 corners, all in the same town and range, may be recorded on this certificate.

A. Description of original monument and accessories and/or subsequent restoration:

1817 William Preston Set post GLO

B. Description of corner evidence found and/or method applied in restoring or reestablishing corner:

Found pipe at the SE top of bank of drainage ditches running west and north. This location is supported by the construction documents for the drain, currently on file with the Macomb County Drain Commission. No other recorded or occupation evidence exists.

North 2672.49' Northeast corner of section 12 (M3) 40 chains or 2640' GLO
 South 2696.36' Southeast corner of section 12 (M5) 40 chains or 2640' GLO

C. Description of monument for corner and accessories established to perpetuate locating the position of the corner:


Replaced existing found iron with a 3/4" by 24" rebar with a 2" diameter aluminum cap stamped "Macomb County Monument MI ACT 345 M4 34970"

264°	9.16'	Set PK and Macomb County Remonumentation tag in the N face of a 11" Swamp Oak
225°	2.73'	Set PK and Macomb County Remonumentation tag in the NE root of a 7" Swamp Oak
8°	16.79'	Set PK and Macomb County Remonumentation tag in the E face of a 9" twin Swamp Oak
108°	120.89'	Set 1/2" iron with "TRAV" cap
0°	106.47'	Set a 3/4" by 24" rebar with a 2" diameter aluminum cap (A4, T4N, R14E)

The selected location is accepted by me and is generally accepted by Professional Surveyors as the best available evidence of the position of the original corner.

ACCEPTED BY THE MACOMB COUNTY SURVEY PEER GROUP AS THE OFFICIAL CORNER UNDER MICHIGAN PUBLIC ACT 345 OF 1990 AT A MEETING HELD ON 10-22-96

William E. Soderberg
 WILLIAM E. SODERBERG, P.S., CHAIRMAN

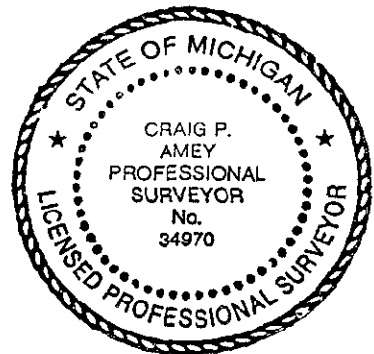

Signed by *C. P. Amey* Date November 30, 1996
 Surveyor's Michigan License No. 34970

609