

LAND CORNER RECORDATION CERTIFICATE
Filing Requirement of Act 74, Mich. P.A. 1970

**SURVEY &
REMONUMENTATION**

For corners in

Macomb Located in: Corner Code #
(County) Ray Township

1. Public Land Survey T 4N R 13E M6
T ___ R ___
T ___ R ___
T ___ R ___

2. Property Controlling S ___ T ___ R ___
in Section S ___ T ___ R ___

3. Miscellaneous S ___ T ___ R ___
Property in Sec. S ___ T ___ R ___

FEB 27 1997

COMMISSION

Register of Deeds Stamp & File Number

4. Lot No. _____, Recorded Plat _____
5. Private Claims _____

I, Craig P. Amey, in a field survey on June 15, 1996 do hereby certify that under requirements of P.A. 74, Michigan P.A. of 1970, the corner points mentioned in lines 1 and 2 above were in conformance with regulations and rules therefore as required in the current manual of survey instructions of the United States Department of the Interior, Bureau of Land Management or by a decree of a Court of Law and /or that the corner points mentioned in lines 3, 4 and 5 above were in conformance with the rules of the Michigan Board of Land Surveyors or by a Decree of a Court of Law; established, re-established, monumented, re-monumented, recovered, found as expressed below:

	A	B	C	D	E	F	G	H	I	J	K	L	M
1													
2	6		5		4		3		2		1		
3													
4	7		8		9		10		11		12		
5													
6	16		17		16		15		14		13		
7													
8	19		20		21		22		23		24		
9													
10	30		29		28		27		26		25		
11													
12	31		32		33		34		35		36		
13													

NOTE: Not more than 4 corners, all in the same town and range, may be recorded on this certificate.

A. Description of original monument and accessories and/or subsequent restoration:

1817 William Preston Set post GLO

B. Description of corner evidence found and/or method applied in restoring or reestablishing corner:

No existing monumentation was found at this location. The location for this corner was established by splitting the distance between M5 and M7. The calculated position is 0.5' north of an old fence cornerpost at the intersection of north, south and west fence lines. The old fence lines are embedded in the trees.

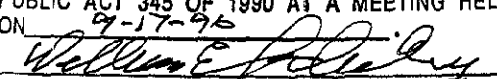
North 2678.11' Northeast corner of section 13 (M5), 40 chains or 2640' GLO
South 2678.11' Southeast corner of section 13 (M7), 40 chains or 2640' GLO

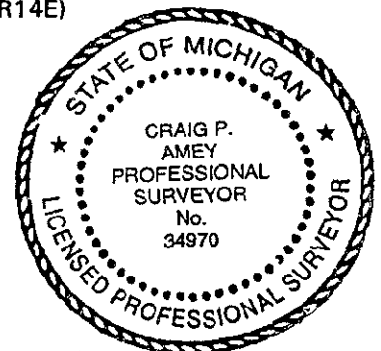
C. Description of monument for corner and accessories established to perpetuate locating the position of the corner:

Set a 3/4" by 24" rebar with a 2" diameter aluminum cap stamped "Macomb County Monument MI ACT 345 M6 34970".

- 100° 6.34' Set PK and Macomb County Remonumentation tag in the N face of a 6" Shag Bark Hickory
- 195° 7.12' Set PK and Macomb County Remonumentation tag in the E face of a 12" Ash.
- 250° 11.42' Set PK and Macomb County Remonumentation tag in the S face of a 10" Ash
- 10° 42.87' Set PK and Macomb County Remonumentation tag in the E face of a 15" Oak
- 0° 70.85' Set 3/4" by 24" rebar with a 2" diameter aluminum cap (A6, T4N, R14E)
- 315° 6.0' Set orange carsonite survey corner post

The selected location is accepted by me and is generally accepted by Professional Surveyors as the best available evidence of the position of the original corner.

ACCEPTED BY THE MACOMB COUNTY SURVEY PEER GROUP AS THE OFFICIAL CORNER UNDER MICHIGAN PUBLIC ACT 345 OF 1990 AT A MEETING HELD ON 09-17-96

WILLIAM E. SODERBERG, P.S., CHAIRMAN



Signed by  Date November 30, 1996

Surveyor's Michigan License No. 34970