

**LAND CORNER RECORDATION CERTIFICATE**  
**Filing Requirement of Act 74, Mich. P.A. 1970**

For corners in

<u>Macomb</u> (County)	Located In:	Corner Code #
	Ray Township	
1. Public Land Survey	T <u>4N</u> R <u>R13E</u>	<u>M7</u>
	T ___ R ___	_____
	T ___ R ___	_____
	T ___ R ___	_____
2. Property Controlling in Section	S ___ T ___ R ___	_____
	S ___ T ___ R ___	_____
3. Miscellaneous Property in Sec.	S ___ T ___ R ___	_____
	S ___ T ___ R ___	_____

**SURVEY &  
REMONUMENTATION**

FEB 27 1997

COMMISSION

Register of Deeds Stamp & File Number

4. Lot No. \_\_\_\_\_, Recorded Plat \_\_\_\_\_  
5. Private Claims \_\_\_\_\_

I, Craig P. Amey, in a field survey on June 15, 1996 do hereby certify that under requirements of P.A. 74, Michigan P.A. of 1970, the corner points mentioned in lines 1 and 2 above were in conformance with regulations and rules therefore as required in the current manual of survey instructions of the United States Department of the Interior, Bureau of Land Management or by a decree of a Court of Law and /or that the corner points mentioned in lines 3, 4 and 5 above were in conformance with the rules of the Michigan Board of Land Surveyors or by a Decree of a Court of Law; established, re-established, monumented, re-monumented, recovered, found as expressed below:

1	A	B	C	D	E	F	G	H	I	J	K	L	M
2		6		5		4		3		2		1	
3													
4		7		8		9		10		11		12	
5													
6		18		17		16		15		14		13	
7													
8		19		20		21		22		23		24	
9													
10		30		29		28		27		26		25	
11													
12		31		32		33		34		35		36	
13													

**NOTE: Not more than 4 corners, all in the same town and range, may be recorded on this certificate.**

**A. Description of original monument and accessories and/or subsequent restoration:**

1817	William Preston	Set post	GLO
1973	George Avendt 16034	Found 1 1/4" pipe with "T" inside	LCRC L2388 P184
1979	George Avendt 16034	Found 1" pipe	Cert of Survey L3168 P966
1979	Robert Smith 16052	Found 1" pipe	Cert of Survey L3168 P967
1981	Herbert Kobs 14097	Found 1" pipe with "T" iron inside	LCRC L3385 P267

**B. Description of corner evidence found and/or method applied in restoring or reestablishing corner:**

Found a 1/2" iron with cap #16034 in the center of 29 Mile Road (Gravel) approximately 0.5' below the surface. The corner matched witnesses from LCRC L2388 P184 and L3385 P267. The corner also fits a tree line extending North.


North 2678.11' East 1/4 corner of section 13 (M6), 40 chains or 2640' GLO, 2678.11' prorated


**C. Description of monument for corner and accessories established to perpetuate locating the position of the corner:**

Replaced existing found iron with a 3/4" by 24" rebar with a 2" diameter aluminum cap stamped "Macomb County Monument MI ACT 345 M7 34970"

0°	26.68'	Set 3/4" rebar with Macomb County Remonumentation cap (A7, T4N, R14E)
40°	31.23'	Found chiseled cross in the W end of a 12" concrete culvert on the N side of 29 Mile Road
190°	32.92'	Found 1/2" iron with cap #16034
265°	80.72'	Found a chiseled cross in the E end of a concrete headwall on the S side of 29 Mile Road
280°	88.45'	Found a chiseled cross in the E end of a concrete headwall on the N side of 29 Mile Road

The selected location is accepted by me and is generally accepted by Professional Surveyors as the best available evidence of the position of the original corner.

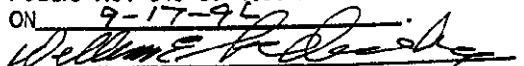ACCEPTED BY THE MACOMB COUNTY SURVEY PEER GROUP AS THE OFFICIAL CORNER UNDER MICHIGAN PUBLIC ACT 345 OF 1990 AT A MEETING HELD ON 9-17-96  
  
WILLIAM E. SODERBERG, P.S., CHAIRMAN

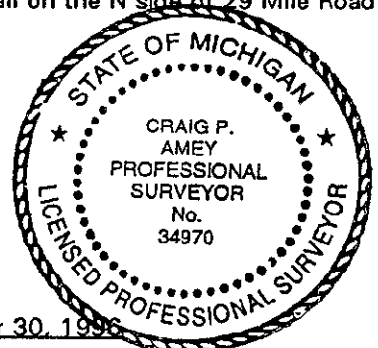

Signed by Craig P. Amey Date November 30, 1996  
Surveyor's Michigan License No. 34970

612