

LAND CORNER RECORDATION CERTIFICATE
 Filing Requirement of Act 74, Mich. P.A. 1970

SURVEY &
 REMONUMENTATION

For corners in


MACOMB
 (County)

Located In: RAY TOWNSHIP Corner Code #

APR 07 1998

SECTION

- | | | | |
|------------------------------------|---------------|-----------------------------|-------------|
| 1. Public Land Survey | | <u>T 4 N R 13 E</u> | <u>M-9</u> |
| | | T <u> </u> R <u> </u> | <u> </u> |
| | | T <u> </u> R <u> </u> | <u> </u> |
| | | T <u> </u> R <u> </u> | <u> </u> |
| 2. Property Controlling in Section | S <u> </u> | T <u> </u> R <u> </u> | <u> </u> |
| | S <u> </u> | T <u> </u> R <u> </u> | <u> </u> |
| 3. Miscellaneous Property in Sec. | S <u> </u> | T <u> </u> R <u> </u> | <u> </u> |
| | S <u> </u> | T <u> </u> R <u> </u> | <u> </u> |

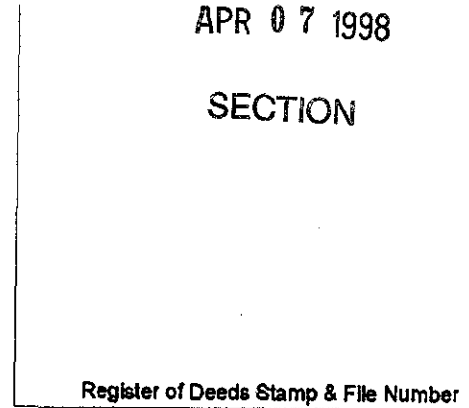

4. Lot No. _____, Recorded Plat _____
 5. Private Claims _____

I, ROBERT H. BIRKETT, in a field survey on JULY 22, 1997 do hereby certify that under requirements of P.A. 74, Michigan P.A. of 1970, the corner points mentioned in lines 1 and 2 above were in conformance with regulations and rules therefore as required in the current manual of survey instructions of the United States Department of the Interior, Bureau of Land Management or by a decree of a Court of Law and for that the corner points mentioned in lines 3, 4 and 5 above were in conformance with the rules of the Michigan Board of Land Surveyors or by a Decree of a Court of Law; established, re-established, monumented, re-monumented, recovered, found as expressed below:

NOTE: Not more than 2 corners, all in the same town and range, may be recorded on this certificate.

	A	B	C	D	E	F	G	H	I	J	K	L	M
1													
2	6	5	4	3	2	1							
3													
4	7	8	9	10	11	12							
5													
6	18	17	16	15	14	13							
7													
8	19	20	21	22	23	24							
9													
10	30	29	28	27	26	25							
11													
12	31	32	33	34	35	36							
13													

A. Description of original monument and accessories and/or subsequent restoration:

- 1817, W. PRESTON D.S., SET CEDAR POST, G.L.O.
- 1972, G. AVENDT, No. 16034, FOUND 1" IRON PIN, L.C.R.C. L. 2327, P. 145.
- 1973, D. SCOTT, No. 12029, FOUND 1" SOLID IRON BAR, L.C.R.C. L.2429, P. 709.
- 1981, H. KOBBS, No., 14097, FOUND 1" IRON BAR, L.C.R.C. L. 3385, P. 259.

ACCEPTED BY THE MACOMB COUNTY SURVEY PEER GROUP AS THE OFFICIAL CORNER UNDER MICHIGAN PUBLIC ACT 345 OF 1990 AT A MEETING HELD ON 11-4-97

William E. Soderberg
 WILLIAM E. SODERBERG, P.S., CHAIRMAN

B. Description of corner evidence found and/or method applied in restoring or reestablishing corner:

FOUND 1" IRON BAR .5' DEEP IN A GRAVEL ROAD 2' SOUTH OF NORTH EDGE. NO FENCE OCCUPATION TO THE NORTH OR SOUTH. FENCE OCCUPIES THE SOUTH RIGHT OF WAY LINE OF 28 MILE ROAD TO THE SOUTH. PRIOR HISTORY COMMON TO A-9, LENOX TOWNSHIP, T. 4 N., R. 14 E., G.L.O. SET A-9 50 LINKS SOUTH.

MONUMENT MATCHES THE WITNESSES (SECTION "C") OF THE ABOVE DESCRIBED DOCUMENT (SECTION "A").

DISTANCES M-9 TO M-8
 G.L.O. 40 CHAINS
 FIELD (GRID) 2673.32 FEET

DISTANCES M-9 TO M-10
 G.L.O. 40 CHAINS
 FIELD (GRID) 2723.20 FEET

C. Description of monument for corner and accessories established to perpetuate locating the position of the corner:

REMOVED 1" IRON BAR AND REPLACED WITH A 3/4" IRON WITH A 2" DIAMETER ALUMINUM CAP STAMPED "MACOMB COUNTY MONUMENT MI ACT 345" M-9, A-9, 41094".

- AZ. 0° - 32.85' - FOUND 1/2" IRON W/CAP No. 14097.
- AZ. 170° - 46.04' - FOUND P.K. NAIL IN SOUTHWEST FACE 6" ELM.
- AZ. 180° - 33.95' - FOUND P.K. NAIL IN EAST FACE 12" OAK.
- AZ. 205° - 35.04' - FOUND P.K. NAIL IN WEST FACE 5" OAK.



Signed by Robert H. Birkett Date 12/10/97
 Surveyor's Michigan License No. 41094

718