

**LAND CORNER RECORDATION CERTIFICATE**  
**Filing Requirement of Act 74, Mich. P.A. 1970**

For corners in

<u>Macomb</u> (County)	Located In: Lenox Township	Corner Code # A2
1. Public Land Survey	T 4N R 14E	_____
	T _____ R _____	_____
	T _____ R _____	_____
	T _____ R _____	_____
2. Property Controlling in Section	S _____ T _____ R _____	_____
	S _____ T _____ R _____	_____
3. Miscellaneous Property in Sec.	S _____ T _____ R _____	_____
	S _____ T _____ R _____	_____

**SURVEY &  
REMONUMENTATION**  
  
FEB 27 1997  
  
**COMMISSION**

Register of Deeds Stamp & File Number

4. Lot No. \_\_\_\_\_, Recorded Plat \_\_\_\_\_  
5. Private Claims \_\_\_\_\_

1	A	B	C	D	E	F	G	H	I	J	K	L	M
2	6		5		4		3		2		1		
3													
4	7		8		9		10		11		12		
5													
6	18		17		16		15		14		13		
7													
8	19		20		21		22		23		24		
9													
10	30		29		28		27		26		25		
11													
12	31		32		33		34		35		36		
13													

I, Craig P. Amey, in a field survey on June 15, 1996 do hereby certify that under requirements of P.A. 74, Michigan P.A. of 1970, the corner points mentioned in lines 1 and 2 above were in conformance with regulations and rules therefore as required in the current manual of survey instructions of the United States Department of the Interior, Bureau of Land Management or by a decree of a Court of Law and /or that the corner points mentioned in lines 3, 4 and 5 above were in conformance with the rules of the Michigan Board of Land Surveyors or by a Decree of a Court of Law; established, re-established, monumented, re-monumented, recovered, found as expressed below:

**NOTE: Not more than 4 corners, all in the same town and range, may be recorded on this certificate.**

A. Description of original monument and accessories and/or subsequent restoration:

1817 William Preston Set post GLO  
1986 Herbert Kobs 14097 Found 1/2" iron LCRC L4055 P671

3. Description of corner evidence found and/or method applied in restoring or reestablishing corner:

Found 1/2" iron with cap #14097 in the center of Omo Road (gravel) approximately six inches below the surface. The existing witnesses match the Kobs LCRC. Iron is at the westerly extension of a tree row.  
LCRC L4055 P671  
Found PK nail in 12" W. Cherry NNE 96.06  
Found 1/2" iron bar w/cap no.14097 S 00°01'40" E 133.47'


North 2556.32' Northwest corner of section 6 (A1) 40 chains or 2640' GLO, 2544.27 prorated  
South 2665.53' Southwest corner of section 6 (A3) 40 chains or 2640' GLO, 2678.18 prorated

B. Description of monument for corner and accessories established to perpetuate locating the position of the corner:


Replaced existing found iron with a 3/4" by 24" rebar with a 2" diameter aluminum cap stamped "Macomb County Monument MI ACT 345 A2 34970"

270°	26.97'	Set 1/2 rebar with "TRAV" cap
344°	65.99'	Set PK and Macomb County Remonumentation tag in the NE face of a utility pole
90°	37.17'	Set PK and Macomb County Remonumentation tag in the S face of a 7" Cherry
180°	133.47'	Set 3/4" rebar with Macomb County Remonumentation cap (M2, T4N, R13E)

The selected location is accepted by me and is generally accepted by Professional Surveyors as the best available evidence of the position of the original corner.

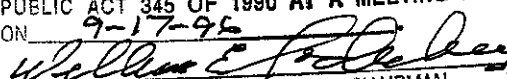ACCEPTED BY THE MACOMB COUNTY SURVEY PEER GROUP AS THE OFFICIAL CORNER UNDER MICHIGAN PUBLIC ACT 345 OF 1990 AT A MEETING HELD ON 9-17-96  
  
WILLIAM E. SODERBERG, P.S., CHAIRMAN

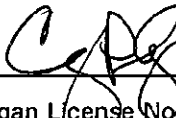

Signed by  Date November 30, 1996  
Surveyor's Michigan License No. 34970