

**LAND CORNER RECORDATION CERTIFICATE**  
**Filing Requirement of Act 74, Mich. P.A. 1970**

**SURVEY &  
REMONUMENTATION**

For corners in

<u>Macomb</u> (County)	Located In:	Corner Code #
	<u>Lenox Township</u>	
1. Public Land Survey	<u>T 4N R 14E</u>	<u>A6</u>
	T ___ R ___	_____
	T ___ R ___	_____
	T ___ R ___	_____
2. Property Controlling in Section	S ___ T ___ R ___	_____
	S ___ T ___ R ___	_____
3. Miscellaneous Property in Sec.	S ___ T ___ R ___	_____
	S ___ T ___ R ___	_____

FEB 27 1997

COMMISSION

Register of Deeds Stamp & File Number

4. Lot No. \_\_\_\_\_, Recorded Plat \_\_\_\_\_  
5. Private Claims \_\_\_\_\_

I, Craig P. Amey, in a field survey on June 15, 1996 do hereby certify that under requirements of P.A. 74, Michigan P.A. of 1970, the corner points mentioned in lines 1 and 2 above were in conformance with regulations and rules therefore as required in the current manual of survey instructions of the United States Department of the Interior, Bureau of Land Management or by a decree of a Court of Law and /or that the corner points mentioned in lines 3, 4 and 5 above were in conformance with the rules of the Michigan Board of Land Surveyors or by a Decree of a Court of Law; established, re-established, monumented, re-monumented, recovered, found as expressed below:

A	B	C	D	E	F	G	H	I	J	K	L	M
1												
2	6	5	4	3	2	1						
3												
4	7	8	9	10	11	12						
5												
6	18	17	16	15	14	13						
7												
8	19	20	21	22	23	24						
9												
10	30	29	28	27	26	25						
11												
12	31	32	33	34	35	36						
13												

**NOTE: Not more than 4 corners, all in the same town and range, may be recorded on this certificate.**

A. Description of original monument and accessories and/or subsequent restoration:

1817	William Preston	Set post	GLO
1973	George Avendt	Set 3/4" Iron	LCRC L2420 P645

B. Description of corner evidence found and/or method applied in restoring or reestablishing corner:

Found 3/4" iron at the base of a fence cornerpost. Old fence lines run north, east and south. The iron matched witnesses from LCRC L2420 P645. The location is heavily wooded. The found iron is on the section line between the reestablished East Quarter Post of section 13, T4N, R13E and the Northeast Corner of section 13, T4N, R13E.

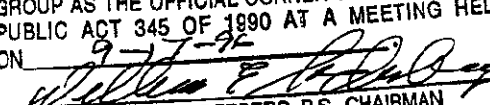
North	2725.88'	Northwest corner of section 18 (A5).	40.1 chains or 2646.60' GLO, 2723.90' prorated
South	2720.71'	Southwest corner of section 18 (A7).	40.1 chains or 2646.60' GLO, 2723.90' prorated

C. Description of monument for corner and accessories established to perpetuate locating the position of the corner:

Replaced existing found iron with a 3/4" by 24" rebar with a 2" diameter aluminum cap stamped "Macomb County Monument MI ACT 345 A6 34970"

- 10° 42.02' Set PK and Macomb County Remonumentation tag above a found nail in the E side of a 24" Oak
- 35° 10.85' Set PK and Macomb County Remonumentation tag above a found nail in the W face of a 8" Hickory
- 150° 13.10' Set PK and Macomb County Remonumentation tag below a found nail in the SW face of a 10 " Oak
- 90° 32.76' Set PK and Macomb County Remonumentation tag below a found nail in the SW face of a 10 " Oak
- 180° 70.85' Set 3/4" rebar with Macomb County Remonumentation cap (M6, T4N,R13E)
- 270° 6.0' Set an orange carsonite survey corner marker

The selected location is accepted by me and is generally accepted by Professional Surveyors as the best available evidence of the position of the original corner

ACCEPTED BY THE MACOMB COUNTY SURVEY PEER GROUP AS THE OFFICIAL CORNER UNDER MICHIGAN PUBLIC ACT 345 OF 1990 AT A MEETING HELD ON 9-17-96  
  
WILLIAM E. SODERBERG, P.S., CHAIRMAN



Signed by Craig P. Amey Date November 30, 1996

Surveyor's Michigan License No. 34970

603