

LAND CORNER RECORDATION CERTIFICATE
Filing Requirement of Act 74, Mich. P.A. 1970

**SURVEY &
REMONUMENTATION**

For corners in

Macomb
(County)

Located In: Lenox Township Corner Code # _____

FEB 27 1997

COMMISSION

- | | | |
|------------------------------------|--------------------------|-----------|
| 1. Public Land Survey | T <u>4N</u> R <u>14E</u> | <u>A7</u> |
| | T _____ R _____ | _____ |
| | T _____ R _____ | _____ |
| | T _____ R _____ | _____ |
| 2. Property Controlling in Section | S _____ T _____ R _____ | _____ |
| | S _____ T _____ R _____ | _____ |
| 3. Miscellaneous Property in Sec. | S _____ T _____ R _____ | _____ |
| | S _____ T _____ R _____ | _____ |

Register of Deeds Stamp & File Number

4. Lot No. _____, Recorded Plat _____
5. Private Claims _____

A	B	C	D	E	F	G	H	I	J	K	L	M
1												
2	6	5	4	3	2	1						
3												
4	7	8	9	10	11	12						
5												
6	18	17	16	15	14	13						
7												
8	19	20	21	22	23	24						
9												
10	30	29	28	27	26	25						
11												
12	31	32	33	34	35	36						
13												

I, Craig P. Amey, in a field survey on June 15, 1996 do hereby certify that under requirements of P.A. 74, Michigan P.A. of 1970, the corner points mentioned in lines 1 and 2 above were in conformance with regulations and rules therefore as required in the current manual of survey instructions of the United States Department of the Interior, Bureau of Land Management or by a decree of a Court of Law and /or that the corner points mentioned in lines 3, 4 and 5 above were in conformance with the rules of the Michigan Board of Land Surveyors or by a Decree of a Court of Law; established, re-established, monumented, re-monumented, recovered, found as expressed below:

NOTE: Not more than 4 corners, all in the same town and range, may be recorded on this certificate.

A. Description of original monument and accessories and/or subsequent restoration:

- | | | | |
|------|---------------------|-------------------------|-----------------|
| 1817 | William Preston | Set post | GLO |
| 1973 | George Avendt 16034 | Found T iron in 1" pipe | LCRC L2420 P645 |
| 1990 | Herbert Kobs 14097 | Found T iron in 1" pipe | LCRC L4866 P798 |

3. Description of corner evidence found and/or method applied in restoring or reestablishing corner:

Found 1" pipe with a "T" iron inside. The pipe is located on the north side of 29 Mile Road on the southerly extension of a tree line to the north. The iron matches witnesses recorded in recorded LCRC's. The pipe is online between the southeast corner of section 13 (M7) T4N,R14E and the east quarter post of section 13 (M6) T4N, R14E.

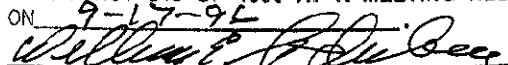
North 2720.71' A6 40 chains or 2640' GLO

D. Description of monument for corner and accessories established to perpetuate locating the position of the corner:

Replaced existing found iron with a 3/4" by 24" rebar with a 2" diameter aluminum cap stamped "Macomb County Monument MI ACT 345 A7 34970"

- | | | |
|------|--------|---|
| 250° | 88.33' | Found a chiseled cross in the E end of a concrete headwall on the N side of 29 Mile Road |
| 265° | 80.72' | Found a chiseled cross in the E end of a concrete headwall on The S side of 29 Mile Road |
| 40° | 31.23' | Found a chiseled cross in the W end of a 12" concrete culvert on The N side of 29 Mile Road |
| 190° | 32.92' | Found a 1/2" iron with cap #16034 |
| 180° | 26.68' | Set 3/4" rebar with Macomb County Remonumentation cap (M7, T4N,R13E) |

The selected location is accepted by me and is generally accepted by Professional Surveyors as the best available evidence of the position of the original corner

ACCEPTED BY THE MACOMB COUNTY SURVEY PEER GROUP AS THE OFFICIAL CORNER UNDER MICHIGAN PUBLIC ACT 345 OF 1990 AT A MEETING HELD ON 9-17-96

WILLIAM E. SODERBERG, P.S., CHAIRMAN



Signed by Craig P. Amey Date November 30, 1996
Surveyor's Michigan License No. 34970

604