

**LAND CORNER RECORDATION CERTIFICATE**  
 Filing Requirement of Act 74, Mich. P.A. 1970

For corners in

**SURVEY &  
 REMONUMENTATION**

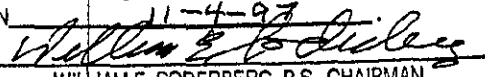
APR 07 1998

SECTION

MACOMB  
 (County)

Located In: LENOX TOWNSHIP Corner Code # \_\_\_\_\_

- |                                       |         |                       |             |
|---------------------------------------|---------|-----------------------|-------------|
| 1. Public Land Survey                 |         | <u>T 4 N. R 14 E.</u> | <u>A-11</u> |
|                                       |         | T _____ R _____       | _____       |
|                                       |         | T _____ R _____       | _____       |
|                                       |         | T _____ R _____       | _____       |
| 2. Property Controlling<br>in Section | S _____ | T _____ R _____       | _____       |
|                                       | S _____ | T _____ R _____       | _____       |
| 3. Miscellaneous<br>Property in Sec.  | S _____ | T _____ R _____       | _____       |
|                                       | S _____ | T _____ R _____       | _____       |

ACCEPTED BY THE MACOMB COUNTY SURVEY PEER GROUP AS THE OFFICIAL CORNER UNDER MICHIGAN PUBLIC ACT 345 OF 1990 AT A MEETING HELD ON 11-4-97  
  
 WILLIAM E. RODERBERG, P.S., CHAIRMAN  
 Register of Deeds Stamp & File Number \_\_\_\_\_

4. Lot No. \_\_\_\_\_, Recorded Plat \_\_\_\_\_  
 5. Private Claims \_\_\_\_\_

I, ROBERT H. BIRKETT, in a field survey on JULY 22, 1997 do hereby certify that under requirements of P.A. 74, Michigan P.A. of 1970, the corner points mentioned in lines 1 and 2 above were in conformance with regulations and rules therefore as required in the current manual of survey instructions of the United States Department of the Interior, Bureau of Land Management or by a decree of a Court of Law and /or that the corner points mentioned in lines 3, 4 and 5 above were in conformance with the rules of the Michigan Board of Land Surveyors or by a Decree of a Court of Law; established, re-established, monumented, re-monumented, recovered, found as expressed below:

	A	B	C	D	E	F	G	H	I	J	K	L	M
1													
2	6			5			4		3		2		1
3													
4	7			8			9		10		11		12
5													
6	18			17			16		15		14		13
7													
8	19			20			21		22		23		24
9													
10	30			29			28		27		26		25
11													
12	31			32			33		34		35		36
13													

**NOTE: Not more than 2 corners, all in the same town and range, may be recorded on this certificate.**

A. Description of original monument and accessories and/or subsequent restoration:  
 1817, W. PRESTON D.S., SET CEDAR POST, G.L.O.  
 1973, D. SCOTT, No. 12029, FOUND POINTED STONE WITH 1/2" ROD BY IT, L.C.R.C. 2429, P. 711 & 712.

B. Description of corner evidence found and/or method applied in restoring or reestablishing corner:  
 FOUND 1/2" IRON SOUTHEAST OF A POINTED STONE, LOCATED NORTH OF ABANDONED 27 MILE ROAD WITH THE REMAINS OF FENCE RUNNING EAST AND WEST.  
 MONUMENT MATCHES THE WITNESSES (SECTION "C") OF THE ABOVE DESCRIBED DOCUMENTS (SECTION "A").  
 DISTANCES A-11 TO A-10  
 G.L.O. NONE  
 FIELD (GRID) 2680.67 FEET  
 DISTANCES A-11 TO A-12  
 G.L.O. NONE  
 FIELD (GRID) 2716.03 FEET

C. Description of monument for corner and accessories established to perpetuate locating the position of the corner:  
 REMOVED 1/2" IRON AND REPLACED WITH A 36" IRON ENCASED IN 4" OF CONCRETE WITH 2" DIAMETER ALUMINUM CAP STAMPED "MACOMB COUNTY MONUMENT MI ACT 345 A-11, 41094". POINTED ROCK REMAINS IN THE ORIGINAL POSITION IT WAS FOUND.

- AZ. 120° - 121.82' - SET MACOMB COUNTY REMON. TAG IN SOUTHWEST FACE 13" HICKORY.
- AZ. 150° - 61.2' - FOUND CENTER OF ROTTING 8" HICKORY STUMP.
- AZ. 180° - 52.65' - MACOMB COUNTY MONUMENTATION CAP FOR M-11 LENOX TOWNSHIP.
- AZ. 190° - 57.43' - SET MACOMB COUNTY REMON. TAG IN SOUTHEAST FACE 4" HAWTHORN.
- AZ. 335° - 46.2' - FOUND CENTER OF ABANDONED ROCK LINED WELL.



Signed by Robert H. Birkett Date 12/10/97  
 Surveyor's Michigan License No. 41094

713