

LAND CORNER RECORDATION CERTIFICATE
Filing Requirement of Act 74, Mich. P.A. 1970

For corners in

MACOMB
 (County)

Located In: LENOX TOWNSHIP
 Corner Code #

- | | | | |
|------------------------------------|-------|-----------------------|-------------|
| 1. Public Land Survey | | <u>T 4 N. R 14 E.</u> | <u>A-12</u> |
| | | T ___ R ___ | _____ |
| | | T ___ R ___ | _____ |
| | | T ___ R ___ | _____ |
| 2. Property Controlling in Section | S ___ | T ___ R ___ | _____ |
| | S ___ | T ___ R ___ | _____ |
| 3. Miscellaneous Property in Sec. | S ___ | T ___ R ___ | _____ |
| | S ___ | T ___ R ___ | _____ |

SURVEY & REMONUMENTATION

APR 07 1998

SECTION

Register of Deeds Stamp & File Number

4. Lot No. _____, Recorded Plat _____
 5. Private Claims _____

I, ROBERT H. BIRKETT, In a field survey on JULY 22, 1997 do hereby certify that under requirements of P.A. 74, Michigan P.A. of 1970, the corner points mentioned in lines 1 and 2 above were in conformance with regulations and rules therefore as required in the current manual of survey instructions of the United States Department of the Interior, Bureau of Land Management or by a decree of a Court of Law and /or that the corner points mentioned in lines 3, 4 and 5 above were in conformance with the rules of the Michigan Board of Land Surveyors or by a Decree of a Court of Law; established, re-established, monumented, re-monumented, recovered, found as expressed below:

	A	B	C	D	E	F	G	H	I	J	K	L	M
1													
2	6		5		4		3		2		1		
3													
4	7		8		9		10		11		12		
5													
6	16		17		16		15		14		13		
7													
8	19		20		21		22		23		24		
9													
10	30		29		28		27		26		25		
11													
12	31		32		33		34		35		36		
13													

NOTE: Not more than 2 corners, all in the same town and range, may be recorded on this certificate.

A. Description of original monument and accessories and/or subsequent restoration:

CORNER WAS NOT SET BY G.L.O.

B. Description of corner evidence found and/or method applied in restoring or reestablishing corner:

FOUND 1" PIPE AT THE WEST END OF AN EAST RUNNING FENCE.
 CORNER COMMON TO M-12 RAY TOWNSHIP, T. 4 N., R 13 E.

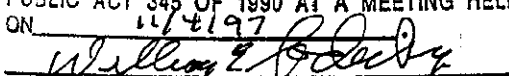
DISTANCES A-12 TO A-11
 G.L.O. NONE
 FIELD (GRID) 2718.13 FEET

DISTANCES A-12 TO A-13
 G.L.O. NONE
 FIELD (GRID) 2667.83 FEET

C. Description of monument for corner and accessories established to perpetuate locating the position of the corner:

REMOVED 1" PIPE AND REPLACED WITH A 36" LONG 1/2" R.R. ENCASED IN 4" OF CONC. WITH 2" DIAMETER ALUMINUM CAP STAMPED "MACOMB COUNTY MONUMENT MI ACT 345 M-12, A-12, 41094"

- AZ. 75° - 397.66' - INTERSECTION NORTHWEST LEG WITH TOP SECOND BRACE FROM BOTTOM DETROIT EDISON TOWER #7747.
- AZ. 95° - 389.44' - INTERSECTION SOUTHWEST LEG WITH TOP SECOND BRACE FROM BOTTOM DETROIT EDISON TOWER #2584.
- AZ. 190° - 63.39' - SET P.K. NAIL W/MACOMB COUNTY REMON. TAG IN EAST FACE 4" ELM.
- AZ. 335° - 193.18' - SET P.K. NAIL W/MACOMB COUNTY REMON TAG IN WEST FACE 10" POPULAR.

ACCEPTED BY THE MACOMB COUNTY SURVEY PEER GROUP AS THE OFFICIAL CORNER UNDER MICHIGAN PUBLIC ACT 345 OF 1990 AT A MEETING HELD ON 11/18/97

 WILLIAM E. SODERBERG, P.S., CHAIRMAN



Signed by Robert H. Birkett Date 12/15/97
 Surveyor's Michigan License No. 41094

714