

LAND CORNER RECORDATION CERTIFICATE
 Filing Requirement of Act 74, Mich. P.A. 1970

For corners in

MACOMB
 (County)

LENEX TOWNSHIP
 Located In: Corner Code #

1091821
 LIBER 9268 PAGE 7
 12/27/1999 01:15:14 P.M.
 MACOMB COUNTY, MI
 CARMELLA SABAUGH, REG/DEEDS

1. Public Land Survey

T 4 N R 14 E F-13

2. Property Controlling in Section

S _____ T _____ R _____

3. Miscellaneous Property in Sec.

S _____ T _____ R _____

SURVEY &
 RE-MONUMENTATION

MAR 17 2000

SECTION

Register of Deeds Stamp & File Number

4. Lot No. _____, Recorded Plat _____
 5. Private Claims _____


1	A	B	C	D	E	F	G	H	I	J	K	L	M
2		6	5		4		3		2		1		
3													
4		7		6		9		10		11		12	
5													
6		18		17		16		15		14		13	
7													
8		19		20		21		22		23		24	
9													
10		30		29		28		27		26		25	
11													
12		31		32		33		34		35		36	
13													

I, ROBERT H. BIRKETT, In a field survey on JULY 10, 1999 do hereby certify that under requirements of P.A. 74, Michigan P.A. of 1970, the corner points mentioned in lines 1 and 2 above were in conformance with regulations and rules therefore as required in the current manual of survey instructions of the United States Department of the Interior, Bureau of Land Management or by a decree of a Court of Law and/or that the corner points mentioned in lines 3, 4 and 5 above were in conformance with the rules of the Michigan Board of Land Surveyors or by a Decree of a Court of Law; established, re-established, monumented, re-monumented, recovered, found as expressed below:

NOTE: Not more than 2 corners, all in the same town and range, may be recorded on this certificate.

A. Description of original monument and accessories and/or subsequent restoration:
 F-13 LENOX .

- 1817, W. PRESTON, GLO, SET WOOD POST
- (a) 1982, H. KOBBS # 14097, FOUND P.K. NAIL IN PAVEMENT, L.C.R.C. L. 3465, P. 173 M.C.R.
- (b) 1988, G. WARD #22445, FOUND P.K., L.C.R.C., L.4546, P. 342 M.C.R.
- (c) 1993, D. KING # 30085, P.K. NAIL, SURVEY, L. 5969, P. 139 M.C.R.
- (d) 1994, D. KING # 30085, FOUND P.K. NAIL IN PAVEMENT, L.C.R.C. L. 6586, P.196 M.C.R.
- (e) 1996, D. KING # 30085, IRON IN MONUMENT BOX, SURVEY, L. 7430, P. 841 M.C.R.

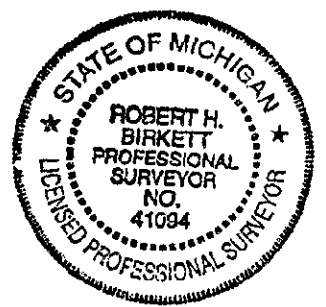

B. Description of corner evidence found and/or method applied in restoring or reestablishing corner:
 F-13 LENOX FOUND 1/2" IRON IN MONUMENT BOX 0.3' SOUTH CENTER LINE ASPHALT 26 MILE AND UNNAMED ROAD TO THE NORTH 0.2' DEEP.
 N.N.E. (c, d, e 51.56') CHISELED X ON S.W. RIM GATE VALVE.

FIELD MEASUREMENTS	(SEE SKETCH ON BACK)		
F-13 TO E-13 LENOX	F-13 TO G-13 LENOX	F-13 TO F-1 CHESTERFIELD	F-13 TO G-1 CHESTERFIELD
G.L.O. - 40 CHAINS (2640')	G.L.O. - 40 CHAINS (2640')	GLO (NONE)	GLO (NONE)
NO RECORDED DISTANCE	D. KING (1993 & 1996) - 2724.55'	RE-MON (1999) - 2314.14'	RE-MON (1999) - 445.04'
RE-MON. (1999) - 2735.60'	RE-MON. (1999) - 2724.41'		

C. Description of monument for corner and accessories established to perpetuate locating the position of the corner:
 F-13 LENOX. REMOVED 1/2" IRON AND SET A 3/4" IRON WITH A 2" DIAMETER ALUMINUM CAP STAMPED "MACOMB COUNTY MONUMENT, MI ACT 345, #41094, F-13" IN EXISTING MONUMENT BOX .

AZ 45° 60.65' - SET REMON TAG ABOVE FOUND P.K. NAIL IN NORTHWEST FACE UTILITY POLE.
 AZ 20° 51.49' - FOUND CHISELED "X" ON SOUTHWEST RIM GATE WELL.
 AZ 175° 36.97' CENTER TOP BOLT HYDRANT.
 AZ 210° 46.03' SET CHISELED "X" NORTH RIM GATE WELL.
 AZ 290° 137.64' FOUND MACOMB COUNTY GEODETIC MARKER.

ACCEPTED BY THE MACOMB COUNTY SURVEY PEER GROUP AS THE OFFICIAL CORNER UNDER MICHIGAN PUBLIC ACT 345 OF 1990 AT A MEETING HELD ON 10/5/99

THE SELECTED LOCATION IS ACCEPTED BY ME AND IS GENERALLY ACCEPTED BY PROFESSIONAL SURVEYORS AS THE BEST AVAILABLE EVIDENCE OF THE POSITION OF THE ORIGINAL CORNER.

Signed by Robert H. Birkett Date 11-23-99
 Surveyor's Michigan License No. 41094

947

MACOMB COUNTY
LENOX TOWNSHIP
TOWN 4 NORTH, RANGE 14 EAST
F-13

