

LAND CORNER RECORDATION CERTIFICATE
 Filing Requirement of Act 74, Mich. P.A. 1970

For corners in

MACOMB
 (County)

LENOX TOWNSHIP
 Located In: Corner Code #

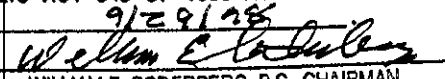
1. Public Land Survey		<u>T 4 N R 14 E</u>	<u>M-2</u>
		T ___ R ___	_____
		T ___ R ___	_____
		T ___ R ___	_____
2. Property Controlling in Section	S ___	T ___ R ___	_____
	S ___	T ___ R ___	_____
3. Miscellaneous Property in Sec.	S ___	T ___ R ___	_____
	S ___	T ___ R ___	_____

SURVEY & REMONUMENTATION

MAR 15 1999

SECTION

ACCEPTED BY THE MACOMB COUNTY SURVEY PEER GROUP AS THE OFFICIAL CORNER UNDER MICHIGAN PUBLIC ACT 345 OF 1990 AT A MEETING HELD ON

9/29/98

 WILLIAM E. SODERBERG, P.S., CHAIRMAN
 Register of Deeds Stamp & File Number

4. Lot No. _____, Recorded Plat _____
 5. Private Claims _____

I, ROBERT H. BIRKETT, in a field survey on JUNE 8, 1998 do hereby certify that under requirements of P.A. 74, Michigan P.A. of 1970, the corner points mentioned in lines 1 and 2 above were in conformance with regulations and rules therefore as required in the current manual of survey instructions of the United States Department of the Interior, Bureau of Land Management or by a decree of a Court of Law and for that the corner points mentioned in lines 3, 4 and 5 above were in conformance with the rules of the Michigan Board of Land Surveyors or by a Decree of a Court of Law, established, re-established, monumented, re-monumented, recovered, found as expressed below:

A	B	C	D	E	F	G	H	I	J	K	L	M
1												
2	6	5	4	3	2	1						
3												
4	7	8	9	10	11	12						
5												
6	18	17	16	15	14	13						
7												
8	19	20	21	22	23	24						
9												
10	30	29	28	27	26	25						
11												
12	31	32	33	34	35	36						
13												

NOTE: Not more than 2 corners, all in the same town and range, may be recorded on this certificate.

A. Description of original monument and accessories and/or subsequent restoration:

1817, W. PRESTON, GLO, SET POST.

- 1) W.S. McALPINE #1015, SET CONCRETE MONUMENT, "SUP. PLAT No. 1", LENOX TOWNSHIP, L. 16 (PLATS), P. 44.
- 2) 1992, A. BUTTERFIELD #21561, FND. CONCRETE MONUMENT, LCRC, L. 5346, P. 156, MCR.
- 3) 1993, M. ROSSOW #24615, FND. CONCRETE MONUMENT, UNRECORDED SURVEY.

B. Description of corner evidence found and/or method applied in restoring or reestablishing corner:

M-2 FOUND CONCRETE MONUMENT ON THE NORTH LINE WOODS WITH REMAINS OF FENCE TO THE SOUTH AND NEW FENCE TO THE NORTH.

- 19.56' (2) - SSW - P.K. NAIL IN S.E. SIDE 44" TWIN POPLAR. (FND. 19.56')
- 6.11' (2) - NNW - CENTER FENCE POST. (FND. 6.11')
- 34.92' (2) - NW - P.K. NAIL IN N.E. SIDE 7" ASH. (FND. 34.92')
- 11.21' (2) - WEST - 10 PENNY NAIL IN SOUTH FACE 14" ASH. (FND. 11.21')
- 13.38' (2) - SOUTH - P.K. NAIL IN 12" OAK. (FND. 13.38')

FIELD MEASUREMENTS

M-2 TO M-1, GLO (1817) - 40 CHAINS (2640')
 ROSSOW (1993) - 2663.76'
 RE-MONUMENTATION (1998) - 2663.72'

M-2 TO M-3, GLO (1817) - 40 CHAINS (2640')
 McALPINE (1936) - 2701.06'
 RE-MONUMENTATION (1998) - 2700.26'

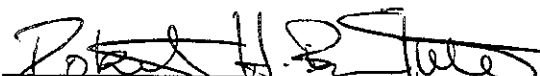


C. Description of monument for corner and accessories established to perpetuate locating the position of the corner:

M-2 PLACED 2" DIAMETER ALUMINUM CAP STAMPED "MACOMB COUNTY MONUMENT, MI ACT 345, #41094, M-2" ON EXISTING MONUMENT.

- AZ. 235° - 19.56' - SET MACOMB RE-MON TAG AT A P.K. NAIL IN SOUTHEAST FACE 44" POPLAR.
- AZ. 340° - 6.11' - FOUND CENTER OF METAL FENCE POST WITH FENCE NORTH AND EAST.
- AZ. 320° - 34.92' - SET MACOMB RE-MON TAG AT P.K. NAIL IN NORTHEAST FACE 7" ASH.
- AZ. 280° - 11.21' - SET MACOMB RE-MON TAG AT 10 PENNY NAIL IN SOUTH FACE 14" ASH.
- AZ. 190° - 13.38' - SET MACOMB RE-MON TAG AT P.K. NAIL IN EAST FACE 12" OAK.

THE SELECTED LOCATION IS ACCEPTED BY ME AND IS GENERALLY ACCEPTED BY PROFESSIONAL SURVEYORS AS THE BEST AVAILABLE EVIDENCE OF THE POSITION OF THE ORIGINAL CORNER.

Signed by  Date 11-24-98
 Surveyor's Michigan License No. 41094

814