


LAND CORNER RECORDATION CERTIFICATE
 Filing Requirement of Act 74, Mich. P.A. 1970

For corners in

MACOMB
 (County)

LENOX TOWNSHIP
 Located In: Corner Code #

- | | | | |
|------------------------------------|-------|----------------------------|------------|
| 1. Public Land Survey | | T <u>4</u> N R <u>14</u> E | <u>M-6</u> |
| | | T ___ R ___ | _____ |
| | | T ___ R ___ | _____ |
| | | T ___ R ___ | _____ |
| 2. Property Controlling in Section | S ___ | T ___ R ___ | _____ |
| | S ___ | T ___ R ___ | _____ |
| 3. Miscellaneous Property in Sec. | S ___ | T ___ R ___ | _____ |
| | S ___ | T ___ R ___ | _____ |

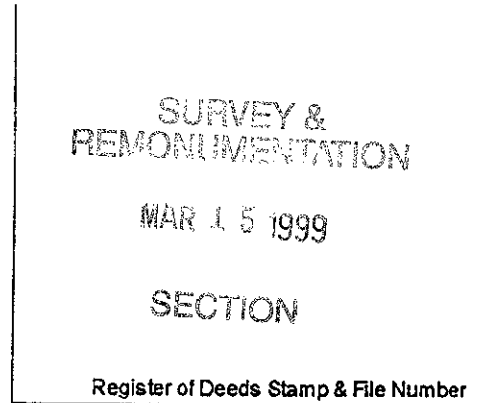

4. Lot No. _____, Recorded Plat _____
 5. Private Claims _____

I, ROBERT H. BIRKETT, in a field survey on JUNE 8, 1998 do hereby certify that under requirements of P.A. 74, Michigan P.A. of 1970, the corner points mentioned in lines 1 and 2 above were in conformance with regulations and rules therefore as required in the current manual of survey instructions of the United States Department of the Interior, Bureau of Land Management or by a decree of a Court of Law and /or that the corner points mentioned in lines 3, 4 and 5 above were in conformance with the rules of the Michigan Board of Land Surveyors or by a Decree of a Court of Law, established, re-established, monumented, re-monumented, recovered, found as expressed below.

NOTE: Not more than 2 corners, all in the same town and range, may be recorded on this certificate.

	A	B	C	D	E	F	G	H	I	J	K	L	M
1													
2	6		5		4		3		2		1		
3													
4	7		8		9		10		11		12		
5													
6	18		17		16		15		14		13		
7													
8	19		20		21		22		23		24		
9													
10	30		29		28		27		26		25		
11													
12	31		32		33		34		35		36		
13													

A. Description of original monument and accessories and/or subsequent restoration:
SEE BACK

B. Description of corner evidence found and/or method applied in restoring or reestablishing corner:
 M-6 FOUND 1" IRON IN A MONUMENT BOX ON THE CENTERLINE OF ASPHALT COUNTY LINE ROAD.
 CORNER COMMOM TO A-6, CASCO TOWNSHIP, ST. CLAIR COUNTY, T. 4N., R. 15 E.

- 2, 3) 32.95' S.E. TO P.K. IN N. FACE T.P. - 3" ABOVE GROUND. (FND. 32.78')
- 3) 37.24' NE TO P.K. W/SCRC TAG IN S. FACE 10' ASH. (FND. 37.13')
- 4) S 30° E 59.38' NAIL SW SIDE 24" MAPLE. (FND. 59.30')
- 4) N 60° E 42.25' CEN. CONC. RW MARKER. (FND. 42.2')
- 5) FND. P.K. NAIL IN 16" ASH - NE - 37.14'. (FND. 37.13')
- 5) NAIL IN SW ROOT 24" BEECH - SE - 59.35'. (FND. 59.30')

ACCEPTED BY THE MACOMB COUNTY SURVEY PEER GROUP AS THE OFFICIAL CORNER UNDER MICHIGAN PUBLIC ACT 345 OF 1990 AT A MEETING HELD ON 9/29/98

 WILLIAM E. SODERBERG, P.S., CHAIRMAN

FIELD DISTANCES - SEE BACK

- C. Description of monument for corner and accessories established to perpetuate locating the position of the corner:
 M-6 REPLACED 1" PIPE IN EXISTING MONUMENT BOX WITH A 3/4" X 24" RE-BAR WITH A 2" DIAMETER ALUMINUM CAP STAMPED "MACOMB COUNTY MONUMENT, MI ACT 345, #41094, M-6".
- AZ. 35° - 43.91' - FOUND P.K. NAIL WITH S.C.C.R.C. TAG IN NORTHWEST FACE G.T.E. RISER POST.
 - AZ. 40° - 42.2' - FOUND CENTER BASE OF CONCRETE RW MARKER.
 - AZ. 65° - 37.13' - FOUND P.K. NAIL WITH S.C.C.R.C. TAG IN SOUTH FACE 15" ASH.
 - AZ. 110° - 32.63' - FOUND P.K. NAIL WITH S.C.C.R.C. TAG IN NORTH FACE G.T.E. POLE.
 - AZ. 110° - 32.78' - FOUND P.K. NAIL WITH S.C.C.R.C. TAG IN SOUTH FACE G.T.E. POLE.
 - AZ. 140° - 59.30' - FOUND P.K. NAIL WITH S.C.C.R.C. TAG IN SOUTHWEST ROOT 21" BEECH.
 - AZ. 195° - 82.56' - FOUND P.K. NAIL WITH S.C.C.R.C. TAG IN EAST FACE UTILITY POLE.
 - AZ. 220° - 58.26' - FOUND P.K. NAIL IN SOUTHEAST FACE 20' ASH.
 - AZ. 260° - 53.68' - FOUND P.K. NAIL WITH S.C.C.R.C. TAG IN NORTH FACE 8" ASH.

THE SELECTED LOCATION IS ACCEPTED BY ME AND IS GENERALLY ACCEPTED BY PROFESSIONAL SURVEYORS AS THE BEST AVAILABLE EVIDENCE OF THE POSITION OF THE ORIGINAL CORNER.

Signed by Robert H. Birkett Date 11-24-98
 Surveyor's Michigan License No. 41094



818

SURVEY &
REMONUMENTATION

MAR 15 1999

A. Description of original monument and accessories and/or subsequent restoration:

SECTION

FROM FRONT

1817 W. PRESTON, GLO, SET POST

- 1) 1977, H. KOBS #14097, 1" IRON BAR, L 1 (CORNERS), P. 665, S.C.C.R.
- 2) 1977, C. ALLOWAY #12043, 1" IRON BAR, L 4 (CORNERS), P. 124, S.C.C.R.
- 3) 1977, ST. CLAIR COUNTY ROAD COM., 1" IRON BAR ON SURFACE IN ROAD CENTERLINE, FIELD NOTES.
- 4) 1987, R. BROWN #24558, MONUMENT BOX, SURVEY UNRECORDED.
- 5) 1988, D. KING #30085, 1" BAR IN MONUMENT BOX, L 6 (CORNERS), P. 46, S.C.C.R.
- 6) 199*, UNKNOWN CALCULATIONS SHEET WITH SECTION LINE DISTANCE.

FIELD DISTANCES

M-6 TO M-5, GLO (1817) - 40 CHAINS (2640')
LANSKY (UNKNOWN) - 2688.01'
S.C.C.R.C. (1995) - 2688.16'
RE-MONUMENTATION (1998) - 2688.17'

M-6 TO M-7, GLO (1817) - 40 CHAINS (2640')
UNKNOWN CALCULATION SHEET (199*) - 2698.50'
RE-MONUMENTATION (1998) - 2698.35'

C0863667 LIBER:08565 PAGE:912 09:45A 01/19/1999
CARMELLA SABAUGH-MACOMB COUNTY, MI REG/DEEDS