

LAND CORNER RECORDATION CERTIFICATE  
 Filing Requirement of Act 74, Mich. P.A. 1970

For corners in

MACOMB  
 (County)

LENOX TOWNSHIP  
 Located In: Corner Code #

- |                                    |       |                     |            |
|------------------------------------|-------|---------------------|------------|
| 1. Public Land Survey              |       | <u>T 4 N R 14 E</u> | <u>M-9</u> |
|                                    |       | T ___ R ___         | _____      |
|                                    |       | T ___ R ___         | _____      |
|                                    |       | T ___ R ___         | _____      |
| 2. Property Controlling in Section | S ___ | T ___ R ___         | _____      |
|                                    | S ___ | T ___ R ___         | _____      |
| 3. Miscellaneous Property in Sec.  | S ___ | T ___ R ___         | _____      |
|                                    | S ___ | T ___ R ___         | _____      |

SURVEY &  
 REMONUMENTATION

MAR 15 1999

SECTION

Register of Deeds Stamp & File Number

4. Lot No. \_\_\_\_\_, Recorded Plat \_\_\_\_\_  
 5. Private Claims \_\_\_\_\_

I, ROBERT H. BIRKETT, in a field survey on JULY 28, 1998 do hereby certify that under requirements of P.A. 74, Michigan P.A. of 1970, the corner points mentioned in lines 1 and 2 above were in conformance with regulations and rules therefore as required in the current manual of survey instructions of the United States Department of the Interior, Bureau of Land Management or by a decree of a Court of Law and /or that the corner points mentioned in lines 3, 4 and 5 above were in conformance with the rules of the Michigan Board of Land Surveyors or by a Decree of a Court of Law, established, re-established, monumented, re-monumented, recovered, found as expressed below:

NOTE: Not more than 2 corners, all in the same town and range, may be recorded on this certificate.

	A	B	C	D	E	F	G	H	I	J	K	L	M
1													
2	6			5			4		3		2		1
3													
4	7			8			9		10		11		12
5													
6	18			17			16		15		14		13
7													
8	19			20			21		22		23		24
9													
10	30			29			28		27		26		25
11													
12	31			32			33		34		35		36
13													

A. Description of original monument and accessories and/or subsequent restoration:

SEE BACK

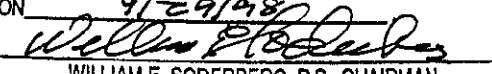
B. Description of corner evidence found and/or method applied in restoring or reestablishing corner:

M-9 FOUND 1" BAR IN MONUMENT BOX CENTER OF COUNTY LINE ROAD AT INTERSECTION OF 28 MILE ROAD (WEST) TO, 1.4' DEEP.

DISTANCE BETWEEN M-9 LENOX TWP., MACOMB CNTY & A-9 CASCO TWP., ST. CLAIR CNTY. (FND 9.85')

- SOUTH 9.90'(1, 4) 9.9'(3, 5) 9.91'(8)
- N.E. - 23.23'(1) 23.25'(3, 5) - CENTER USGS MONUMENT BOX. (FND. 23.45')
- N.E. - 43.58'(1) 43.60'(2, 4, 6, 7) - MCRC TAG IN SOUTH FACE DE POLE. (FND 43.62')
- S.E. - 67.96'(2) 67.92(3, 5) 67.93(4, 6, 7) - P.K. NAIL S. FACE U.P. (FND 68.00')
- S.W. - 49.07(2) - MASONARY NAIL @ N.W. CORNER HEADWALL. (FND. 49.13')
- S.W. - 103.16'(6, 7) - P.K. NAIL IN N.W. FACE MULTI-STEMMED MAPLE. (FND. 103.22')
- W.N.W. - 139.60'(6, 7) - P.K. NAIL IN SOUTH FACE U.P. (FND. 139.69')

ACCEPTED BY THE MACOMB COUNTY SURVEY PEEI GROUP AS THE OFFICIAL CORNER UNDER MICHIGAN PUBLIC ACT 345 OF 1990 AT A MEETING HELD ON


9/29/98  
  
 WILLIAM E. SODERBERG, P.S., CHAIRMAN

FIELD DISTANCES - SEE BACK

C. Description of monument for corner and accessories established to perpetuate locating the position of the corner:

- M-9 REPLACED 1" IRON IN EXISTING MONUMENT BOX WITH A 3/4" X 24" RE-BAR WITH A 2" DIAMETER ALUMINUM CAP STAMPED "MACOMB COUNTY MONUMENT, MI ACT 345, #41094, M-9".
- AZ. 45° - 43.62' - FOUND P.K. NAIL WITH MCRC TAG IN SOUTHEAST FACE OF UTILITY POLE WITH LIGHT.
- AZ. 50° - 23.45' - FOUND CENTER OF MONUMENT BOX CONTAINING USGS BENCH MARK TABLET.
- AZ. 125° - 68.00' - FOUND P.K. NAIL WITH MCRC TAG ABOVE P.K. NAIL IN SOUTHWEST FACE GTE POLE.
- AZ. 180° - 9.85' - FOUND 5/8" BRASS ROD IN MONUMENT BOX, A-9 CASO TWP., T. 4 N., R. 15 E., ST. CLAIR COUNTY.
- AZ. 190° - 102.78' - FOUND P.K. NAIL WITH SDA TAG IN SOUTHEAST FACE TWIN 10" MAPLE.
- AZ. 325° - 102.00' - FOUND P.K. NAIL WITH SDA TAG IN NORTHEAST FACE 30" TREE.

THE SELECTED LOCATION IS ACCEPTED BY ME AND IS GENERALLY ACCEPTED BY PROFESSIONAL SURVEYORS AS THE BEST AVAILABLE EVIDENCE OF THE POSITION OF THE ORIGINAL CORNER.

Signed by  Date 11-24-98  
 Surveyor's Michigan License No. 41094



SURVEY &  
REMONUMENTATION

MAR 15 1999

SECTION

C0863670 LIBER:08565 PAGE:918 09:45A 01/19/1999  
CARMELLA SABAUGH-MACOMB COUNTY, MI REG/DEEDS

A. Description of original monument and accessories and/or subsequent restoration: FROM FRONT

M-9 1817, W. PRESTON, GLO, SET POST

- 1) 1977, ST. CLAIR CO. ROAD COM., 5/8" BRASS PIN, FIELD NOTES.
- 2) 1987, McNEELY, LINCOLN, 1" IRON IN MON. BOX, FIELD NOTES, UNRECORDED SURVEY.
- 3) 1992, G. JAMES #19835, MON. BOX, UNRECORDED SURVEY.
- 4) 1993, SPALDING, DeDECKER, 1" BAR IN MON. BOX, FIELD NOTES.
- 5) 1995, G. JAMES # 19835, MON. BOX, UNRECORDED SURVEY.
- 6) 1996, SPALDING, DeDECKER, 1" BAR IN MON. BOX, UNRECORDED SURVEY.
- 7) 1996, G. PLATZ # 38121, 1" BAR IN MON. BOX, UNRECORDED LC.R.C.
- 8) 1996, SPALDING, DeDECKER, 1" BAR IN MON. BOX, UNRECORDED SURVEY.

FIELD DISTANCES - FROM FRONT

M-9 TO M-8, GLO(1817) - 40 CHAINS (2640')

McNEELY, LINCOLN (1987) - 2697.61'

JAMES ( 1992) - 2697.75'

JAMES (1995) - 2697.66'

RE-MONUMENTATION (1998) - 2697.63'